


**CURVE #14**

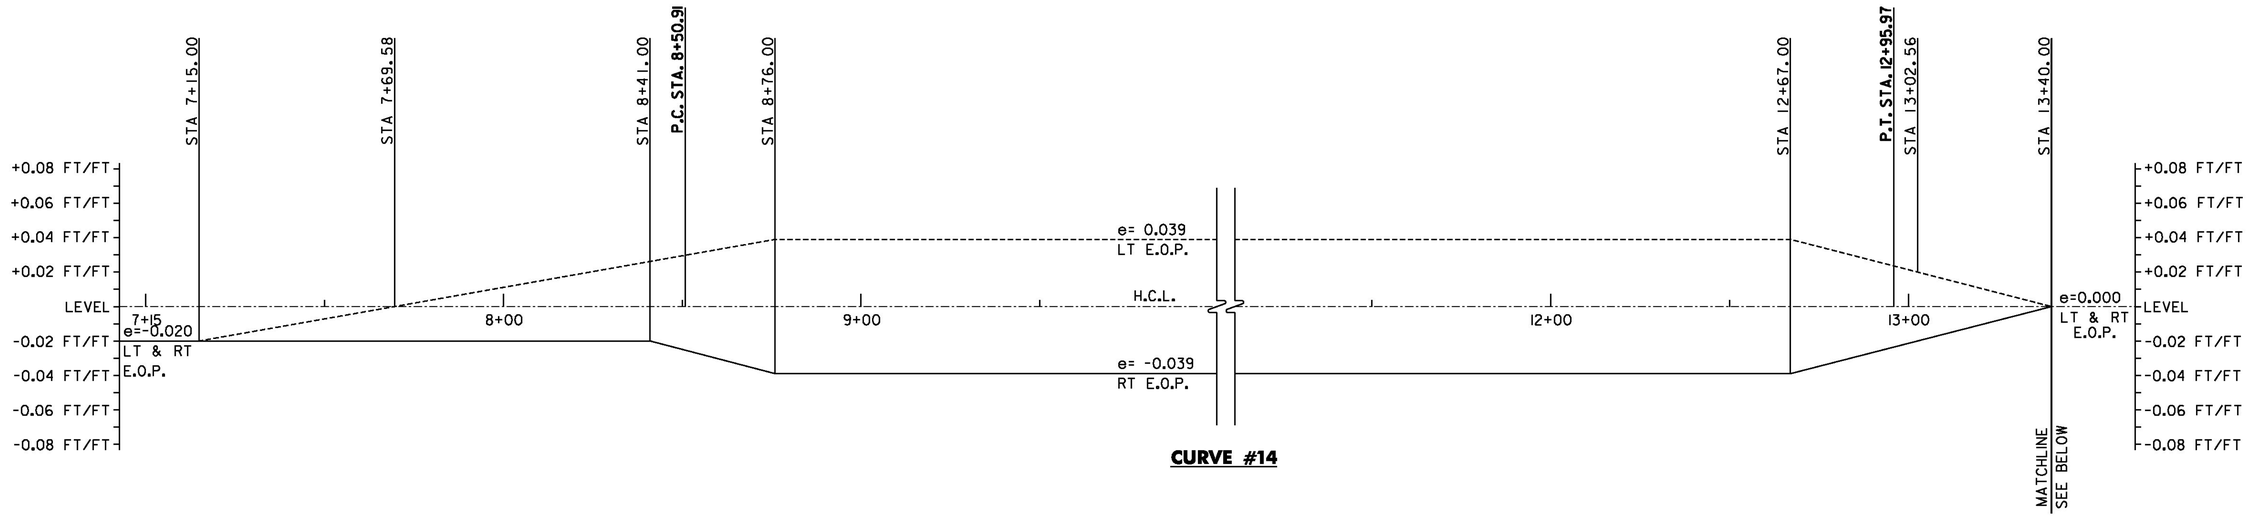


**CURVE #15**

0 20 40
SCALE IN FEET

Stantec

| | |
|---|---|
| PROJECT NAME: | RANDOLPH-ROXBURY |
| PROJECT NUMBER: | ER STP 0187(11) |
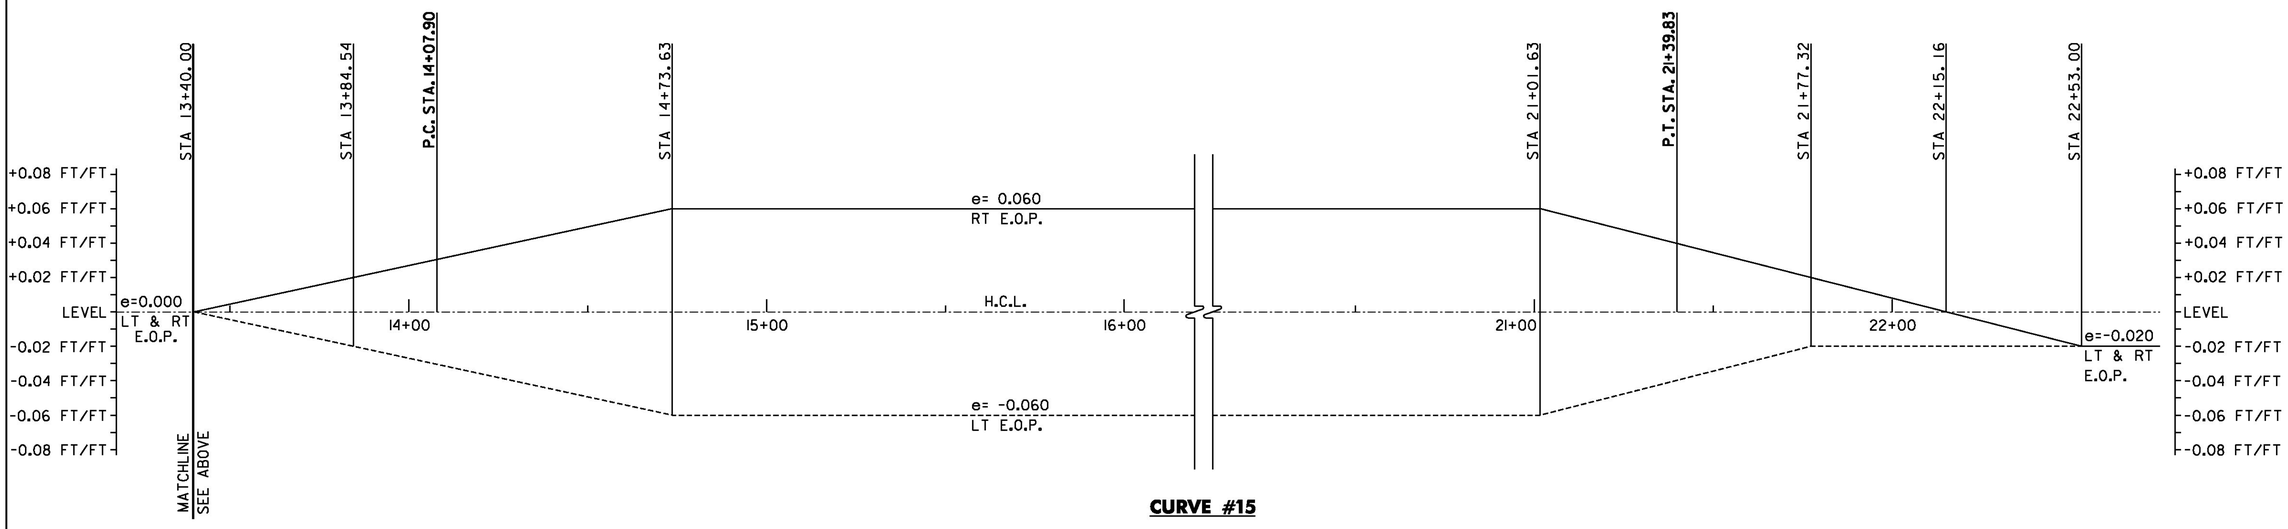
| | |
|---|---|
| FILE NAME: z13C182sup.dgn | PLOT DATE: 11/17/2014 |
| PROJECT LEADER: M. FOISY | DRAWN BY: G. BURGMEIER |
| DESIGNED BY: I. MAYNARD | CHECKED BY: M. FOISY |
| **BANKING DIAGRAM SHEET 4** | SHEET 153 OF 545 |