STATE OF VERMONT
AGENCY OF TRANSPORTATION

TRAFFIC SIGN SUMMARY SHEET 20

MILEMARKER, STATION, OR SIGN NUMBER	SIGN LEGEND	EA	SIGN DIMENSIONS WIDTH (in)	SIGN DIMENSIONS HEIGHT (in)	NEW & SALVAGED SIGNS "A"	"B"	SALV SIGN	SALV TIS	EXIST POST RETAIN	EXIST POST SALVAGE	NO. OF POSTS	NEW SIGN POSTS FLANGED CHANNEL lb/ft 1.12	2.0	3.0	SQUARE STEEL (in) 1.75 lb/ft 1.88	2.0 lb/ft 2.42	2.5 lb/ft 3.35	ANCHOR	SLEEVE	TUBULAR ALUMINUM Ø (in) 3.0 lb/ft 1.3	4.0 lb/ft 1.7	4.0 MOD lb/ft 1.7	FOUNDATION	TUBULAR STEEL Ø (in) 3.0 lb/ft 7.6	3.5 lb/ft 9.0	4.0 lb/ft 10.8	5.0 lb/ft 14.6	W-SHAPE STEEL FTG. SIZE 24"	30"	WEIGHT	POST SIZE	SIGN FRAME REQUIRED	REMARKS	SIGN DETAIL: DETAIL IN SHSM * BOOK	DETAIL ON SHEET NUMBER	STD. SHEET NUMBER
GRANVILLE (CONTINUED)																																				
STA. 24+45, RT		1	12	36	3.00						1					11.00 X		X															OM3-L	X		
STA. 26+40, LT							1				1					15.50 X	X	X															MOUNT SALVAGED SIGN ON NEW POST			
STA. 31+68, LT		1	6	10	0.42						1				X	8.50 X		X															VD-700			T-44
STA. 32+34, RT							1				1					13.50 X		X															MOUNT SALVAGED SIGN ON NEW POST			
STA. 32+34, LT							1				1					15.50 X		X															MOUNT SALVAGED SIGN ON NEW POST			
STA. 34+27, LT	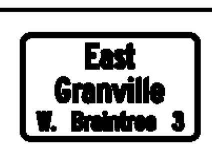	1	30	18	3.75						1					12.00 X		X																	207	
STA. 40+82, LT							1				2					15.00 X 15.00		X															MOUNT SALVAGED SIGN ON NEW POSTS	X		
STA. 42+24, RT	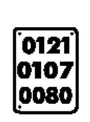	1	6	10	0.42						1				X	8.75 X		X															VD-700			T-44
STA. 52+80, LT		1	6	10	0.42						1				X	8.75 X		X															VD-700			T-44
STA. 63+18, RT	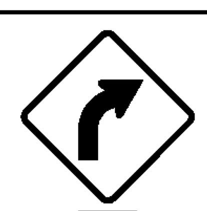	1	30	30	6.25						1					15.75 X	X	X															W1-2R	X		
	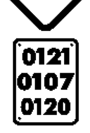	1	6	10	0.42																												VD-700			T-44
													FT	FT	FT 30	FT 111	FT 37		EA	LB	LB	LB		LB	LB	LB	LB									
TOTALS					SF 14.68	SF	EA. 4	SF				FT			FT ~~178~~ 139.25					LB			EA.	LB				EA.	EA.	LB						

* "SHSM"-STANDARD HIGHWAY SIGNS AND MARKINGS

FINAL POST LENGTHS ARE TO BE DETERMINED IN THE FIELD. POST SIZES ARE COMPUTED BASED ON INFORMATION FURNISHED ON THE STANDARD SHEETS AND THE VTRANS "SIGN POST DESIGN GUIDELINE."

PROJECT NAME: RANDOLPH-ROXBURY
PROJECT NUMBER: ER STP 0187(11)

FILE NAME: z13c182frm.dgn
PROJECT LEADER: M. FOISY
DESIGNED BY: G. BURGMEIER
TRAFFIC SIGN SUMMARY SHEET 20

PLOT DATE: 11/17/2014
DRAWN BY: P. BALASCO
CHECKED BY: M. FOISY
SHEET 199 OF 545