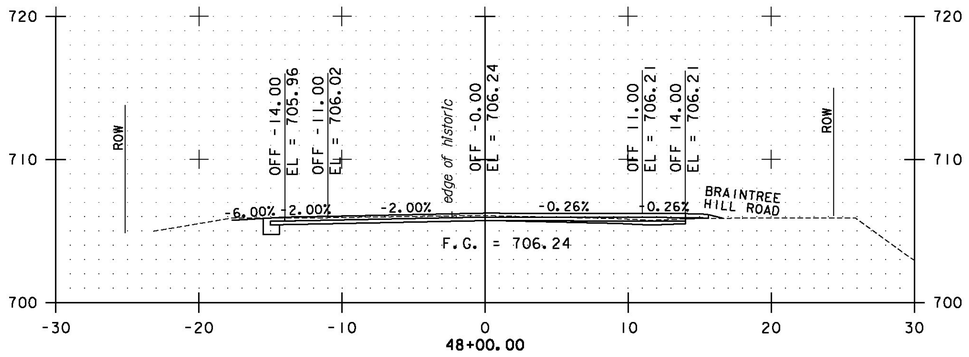

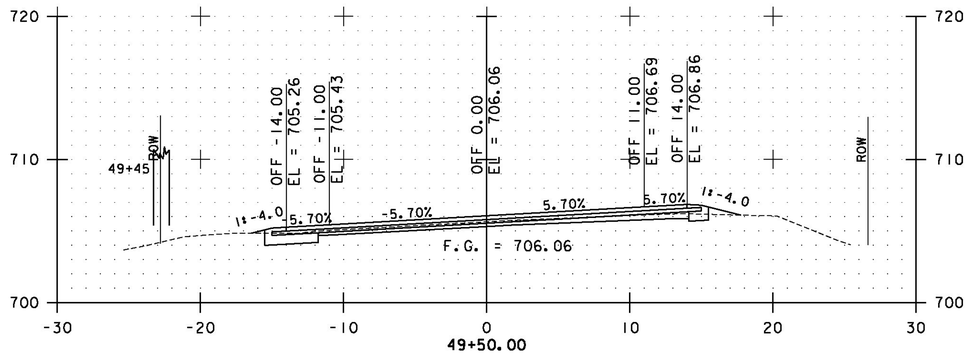

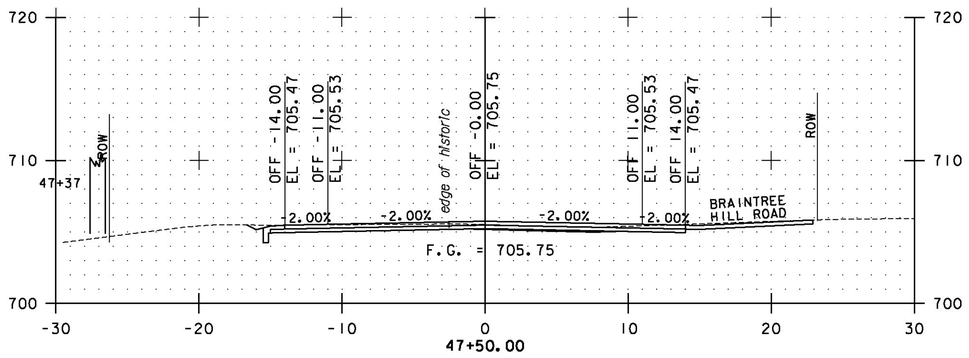

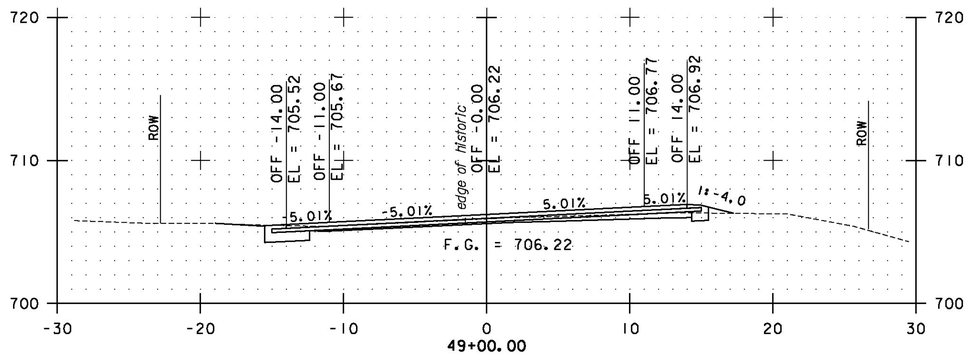

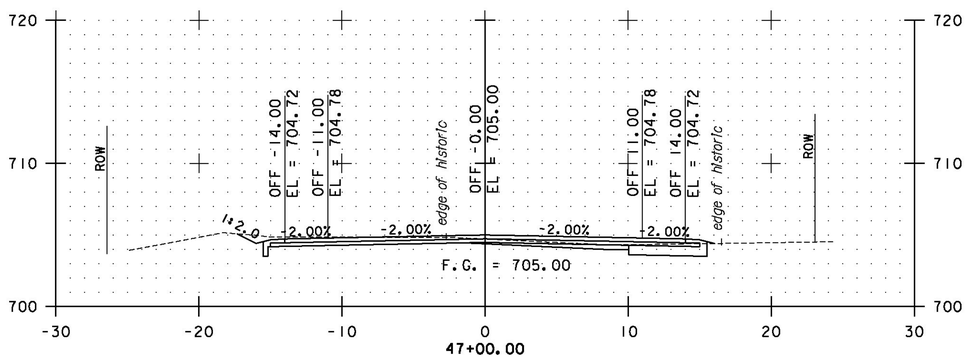

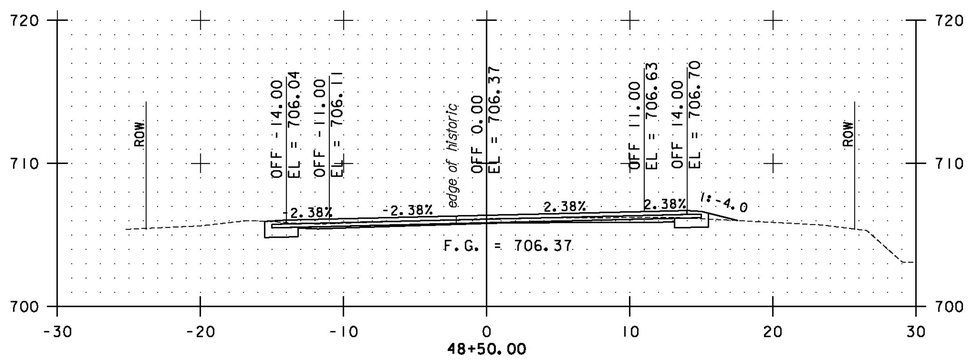

STA. 47+00 TO STA. 49+50

Stantec

PROJECT NAME:	RANDOLPH-ROXBURY
PROJECT NUMBER:	ER STP 0187(11)
FILE NAME: zl3cl82xs.dgn	PLOT DATE: 11/17/2014
PROJECT LEADER: M. FOISY	DRAWN BY: G. BURGMEIER
DESIGNED BY: I. MAYNARD	CHECKED BY: M. FOISY
RANDOLPH CROSS SECTIONS SHEET 14	SHEET 222 OF 545