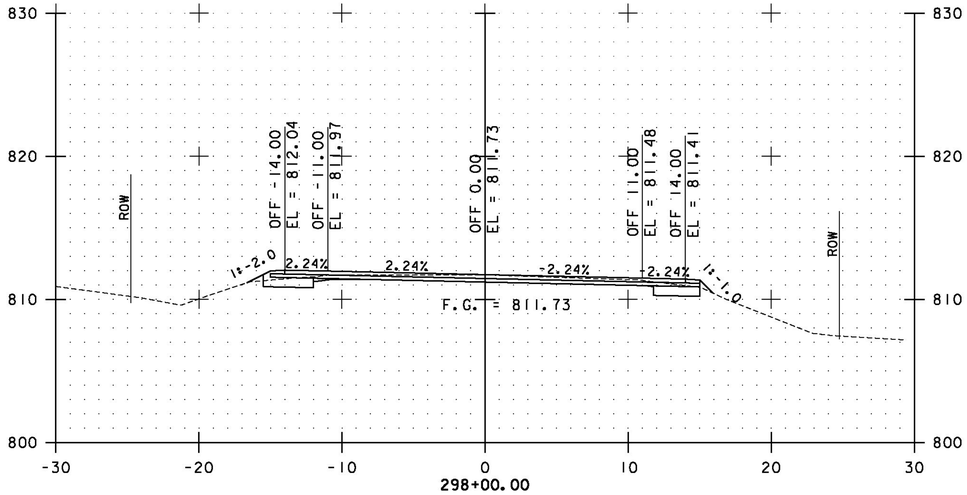


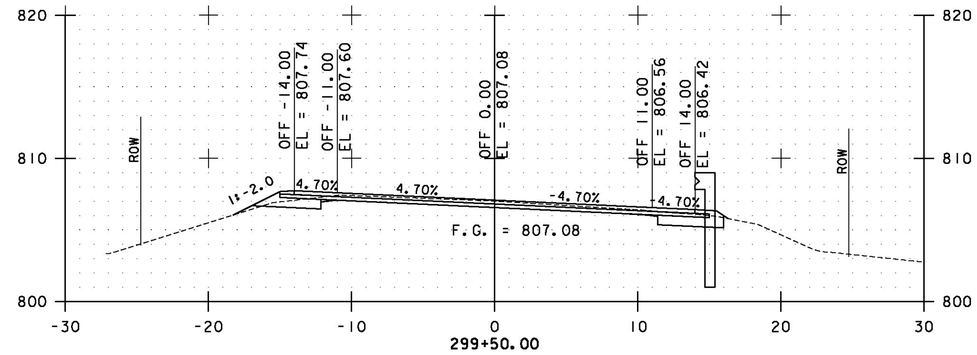


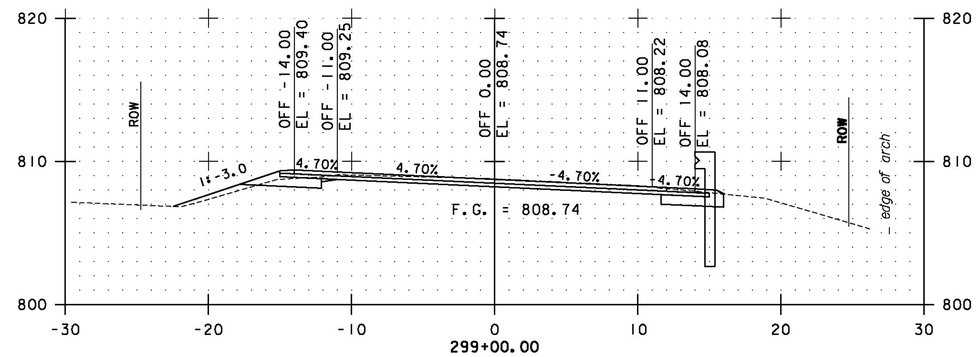


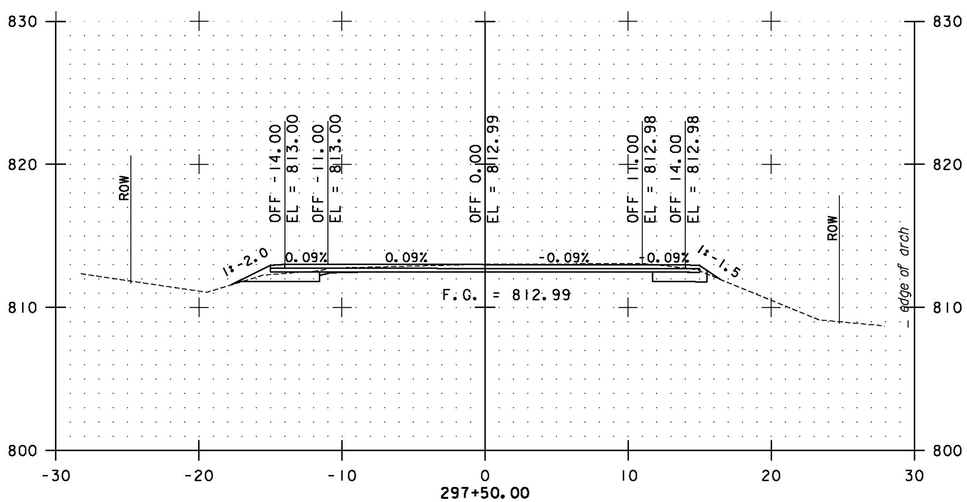


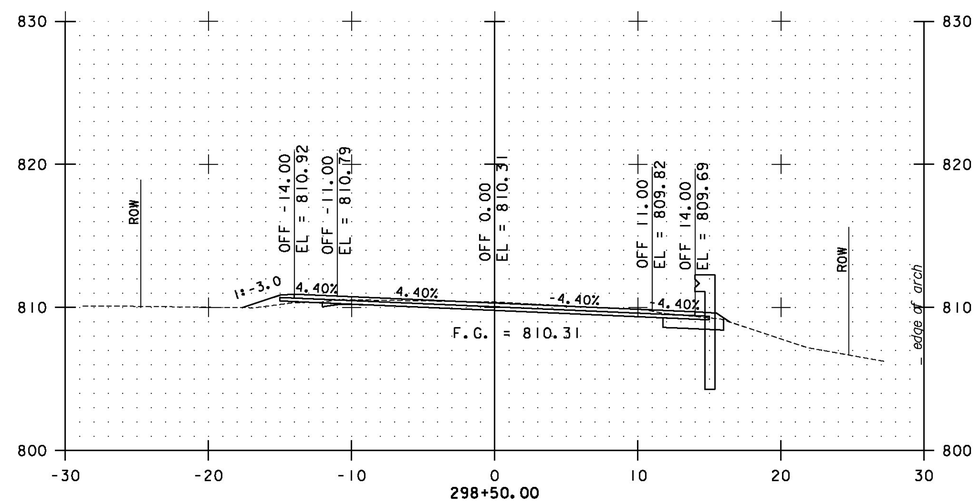


STA. 297+50 TO STA. 299+50

Stantec

| | |
|---|---|
| PROJECT NAME: RANDOLPH-ROXBURY | |
| PROJECT NUMBER: ER STP 0187(11) | |
| FILE NAME: z13c182xs.dgn | PLOT DATE: 11/17/2014 |
| PROJECT LEADER: M. FOISY | DRAWN BY: G. BURGMEIER |
| DESIGNED BY: I. MAYNARD | CHECKED BY: M. FOISY |
| **BRAINTREE CROSS SECTIONS SHEET 136** | SHEET 365 OF 545 |