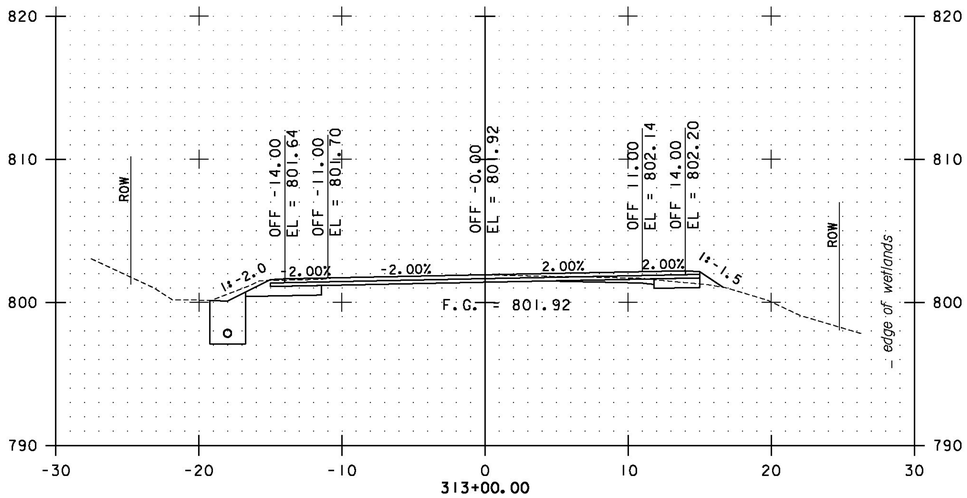

313+00.00

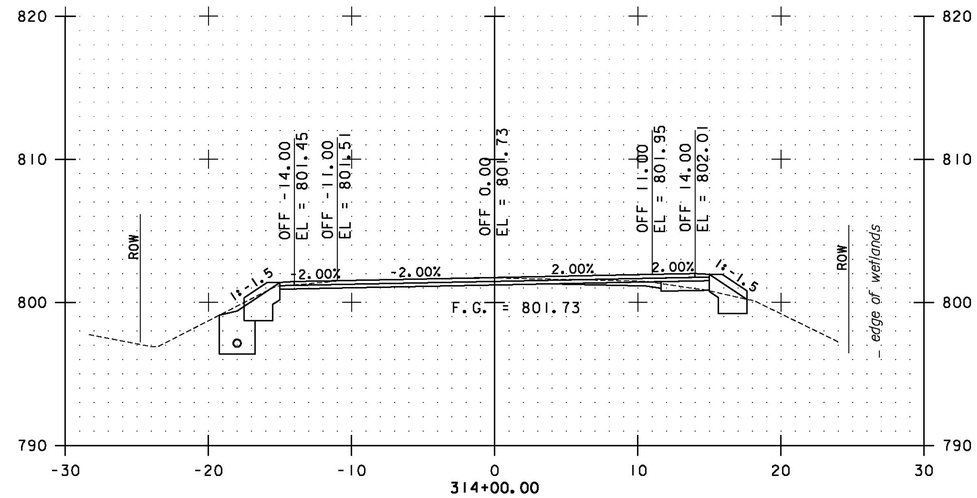

314+00.00

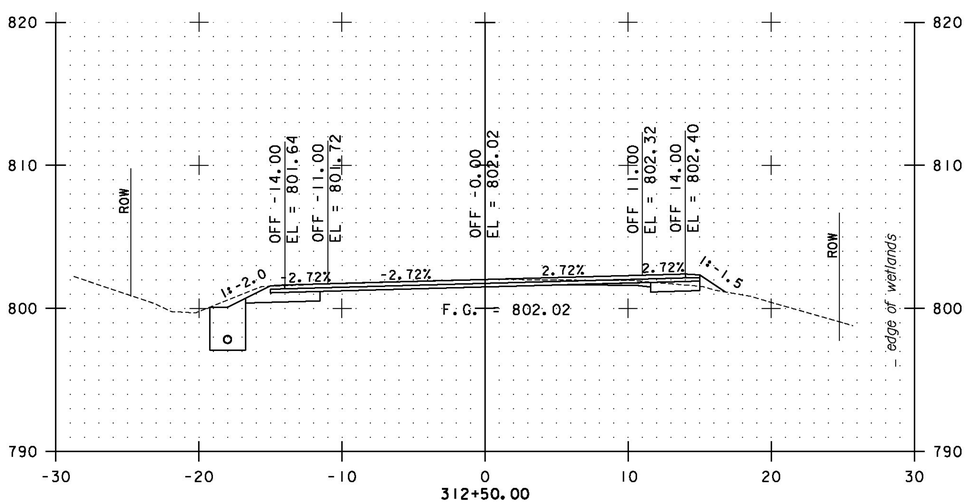

312+50.00

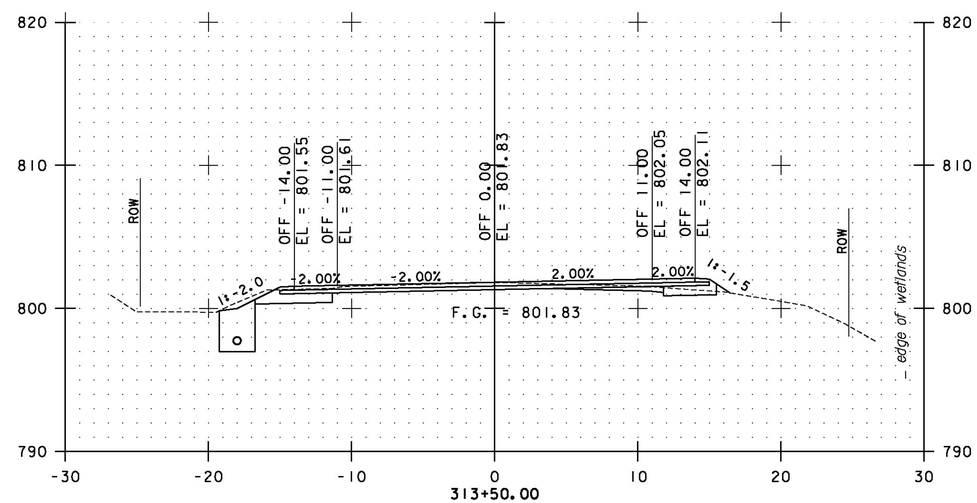

313+50.00

STA. 312+50 TO STA. 314+00

Stantec

PROJECT NAME: RANDOLPH-ROXBURY	
PROJECT NUMBER: ER STP 0187(11)	
FILE NAME: z13c182xs.dgn	PLOT DATE: 11/17/2014
PROJECT LEADER: M. FOISY	DRAWN BY: G. BURGMEIER
DESIGNED BY: I. MAYNARD	CHECKED BY: M. FOISY
BRAINTREE CROSS SECTIONS SHEET 143	SHEET 372 OF 545