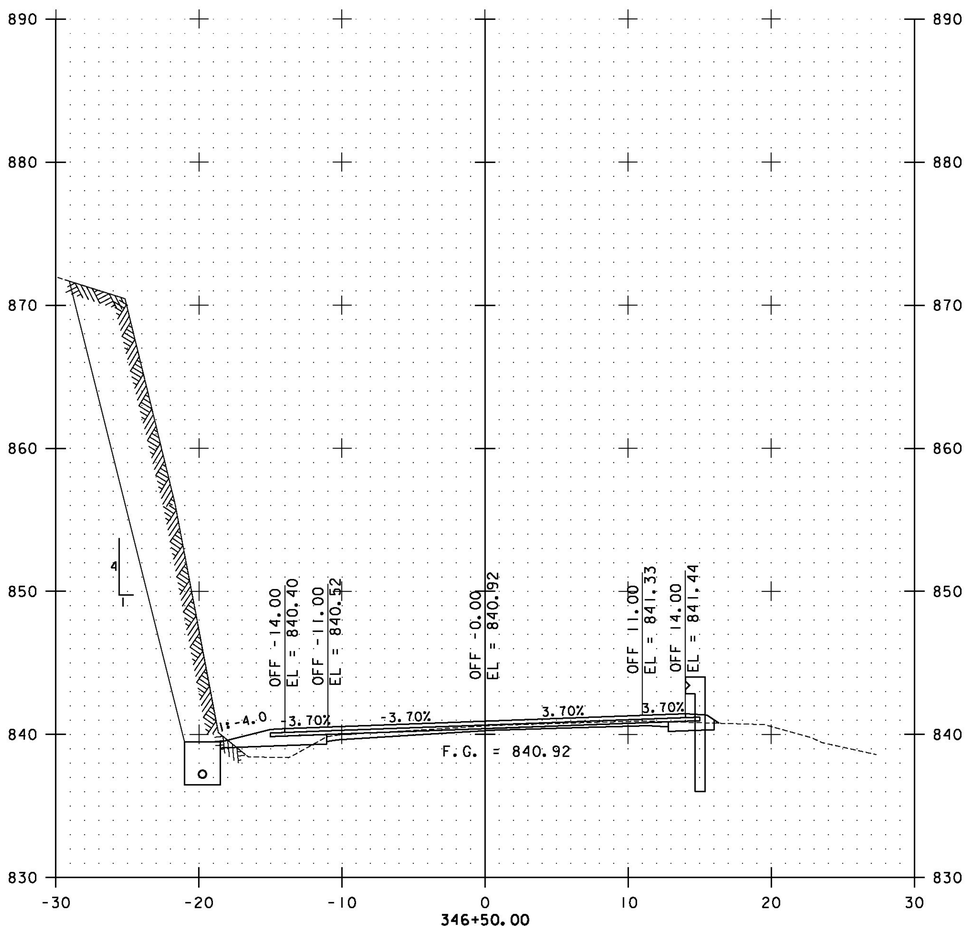

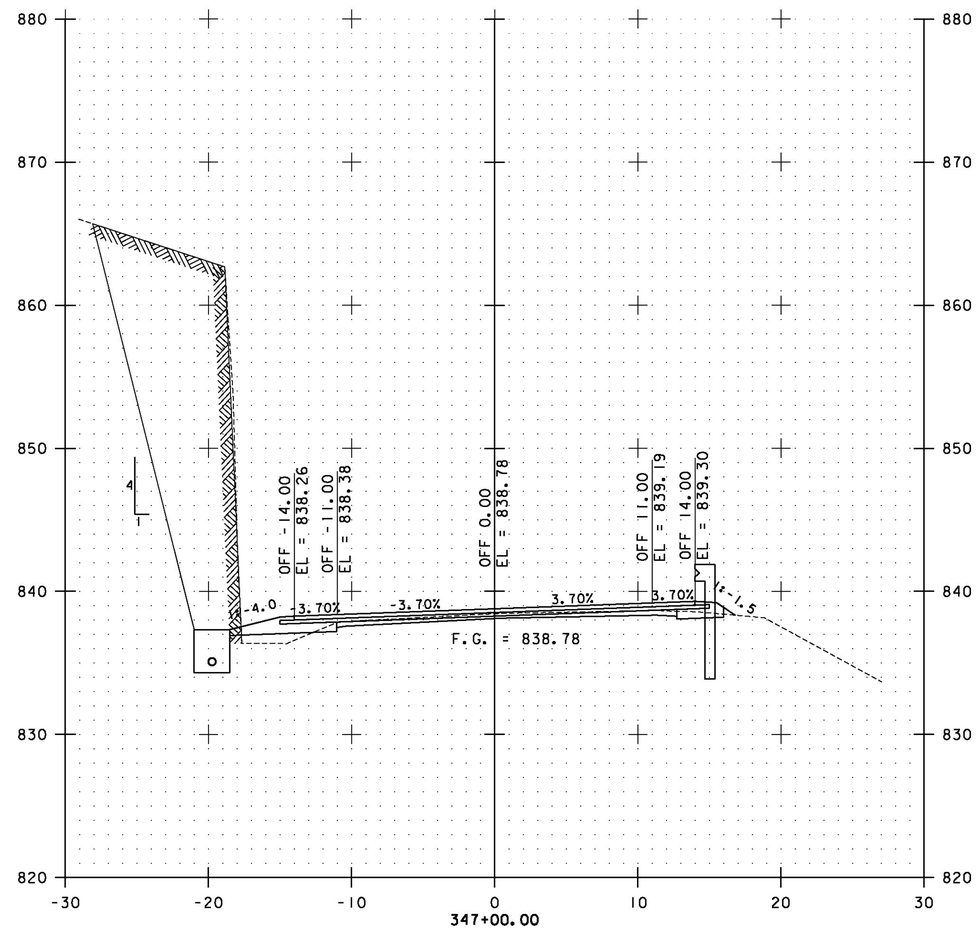

STA. 346+50 TO STA. 347+00

Stantec

PROJECT NAME: RANDOLPH-ROXBURY	
PROJECT NUMBER: ER STP 0187(11)	
FILE NAME: zl3cl82xs.dgn	PLOT DATE: 11/17/2014
PROJECT LEADER: M. FOISY	DRAWN BY: G. BURGMEIER
DESIGNED BY: I. MAYNARD	CHECKED BY: M. FOISY
BRAINTREE CROSS SECTIONS SHEET 161	SHEET 390 OF 545