STONE FILL TYPE I & GRUBBING MATERIAL (6")
~~STA. 225+00 TO 225+78, LT~~

CLEANING CULV. PIPE, IN-PLACE (0 TO 24IN., INCL.)
CULVERT #29, 51LF

DURABLE 4 INCH WHITE LINE (OPTION BID ITEM)
TEMPORARY 4 INCH WHITE LINE, PAINT
(ALL LINES SHALL INCLUDE EDGE LINE BREAKS AND RADII FOR SIDE ROADS)
STA. 225+00 TO 230+00, SOLID LT & RT

DURABLE 4 INCH YELLOW LINE (OPTION BID ITEM)
TEMPORARY 4 INCH YELLOW LINE, PAINT
(ALL LINES SHALL INCLUDE CENTER LINE BREAKS FOR SIDE ROADS)
STA. 225+00 TO 230+00, SOLID LT & RT

STEEL BEAM GUARDRAIL, GALVANIZED
STA. 229+~~09.9~~ 12.6 TO ~~229+34.9~~ 229+19.6, RT
STA. 229+48.9 TO ~~229+73.9~~ 230+00.0, LT

STEEL BEAM GUARDRAIL, GALVANIZED W/8 FEET POSTS
~~STA. 229+34.9 TO 230+00.0, RT~~
~~STA. 229+73.9 TO 230+00.0, LT~~

ANCHOR FOR STEEL BEAM RAIL
STA. 229+~~09.9~~ 12.6, RT
STA. 229+48.9, LT

REMOVING SIGNS
AS SHOWN - 1

BARRIER FENCE
STA. 228+35 TO 230+00, RT

EROSION LOG
STA. 229+15 TO 230+00, RT

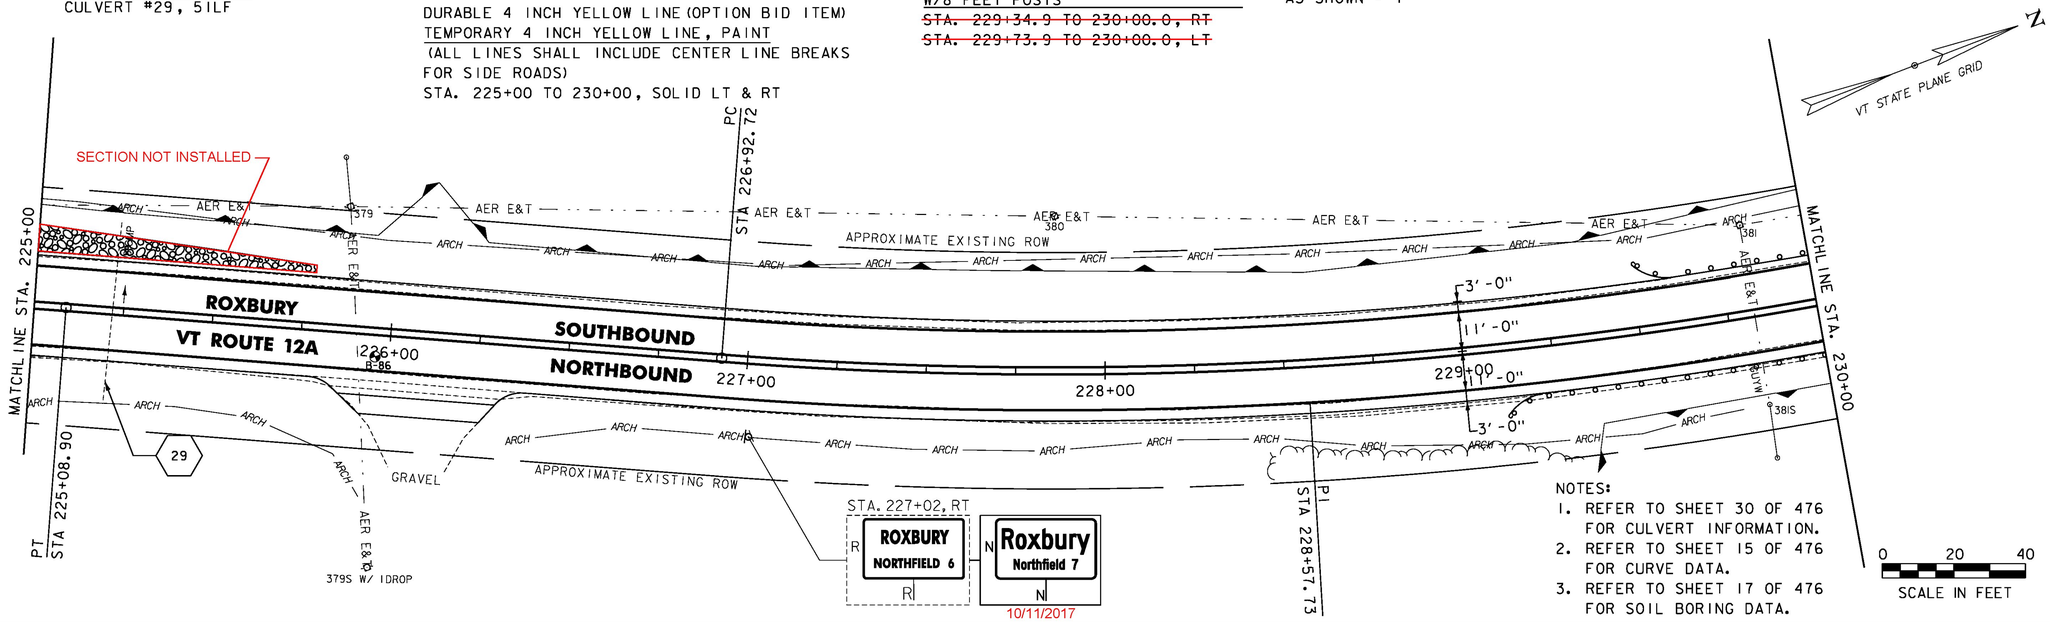

NOTES:
1. REFER TO SHEET 30 OF 476 FOR CULVERT INFORMATION.
2. REFER TO SHEET 15 OF 476 FOR CURVE DATA.
3. REFER TO SHEET 17 OF 476 FOR SOIL BORING DATA.

0 20 40
SCALE IN FEET

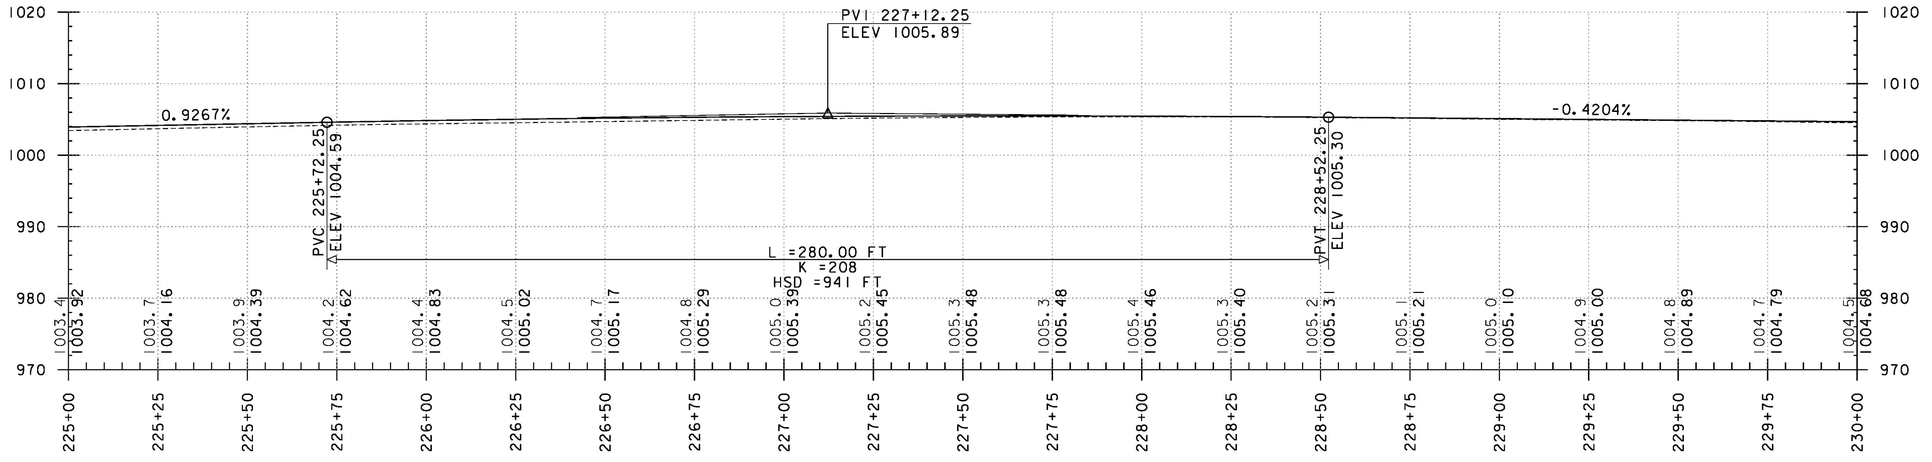

10 5 0 20 40
SCALE IN FEET

Stantec

PROJECT NAME:	ROXBURY - NORTHFIELD
PROJECT NUMBER:	ER STP 0187(13)
FILE NAME: zl3cl84bdr.dgn	PLOT DATE: 5/25/2016
PROJECT LEADER: M. FOISY	DRAWN BY: G. BARRETT
DESIGNED BY: G. BURGMEIER	CHECKED BY: G. EDWARDS
PLAN & PROFILE SHEET 39	SHEET 89 OF 476