DURABLE 4 INCH WHITE LINE (OPTION BID ITEM)
TEMPORARY 4 INCH WHITE LINE, PAINT
(ALL LINES SHALL INCLUDE EDGE LINE BREAKS AND RADII FOR SIDE ROADS)
STA. 214+00 TO 215+29.88, SOLID LT & RT

DURABLE 4 INCH YELLOW LINE (OPTION BID ITEM)
TEMPORARY 4 INCH YELLOW LINE, PAINT
(ALL LINES SHALL INCLUDE CENTER LINE BREAKS FOR SIDE ROADS)
STA. 214+00 TO 215+29.88, SOLID LT & RT

STONE FILL, TYPE I & GRUBBING MATERIAL, 6"
STA. 214+00 TO 214+05, LT

REMOVING SIGNS
AS SHOWN - 4

ERECTING SALVAGED SIGNS
AS SHOWN - 2

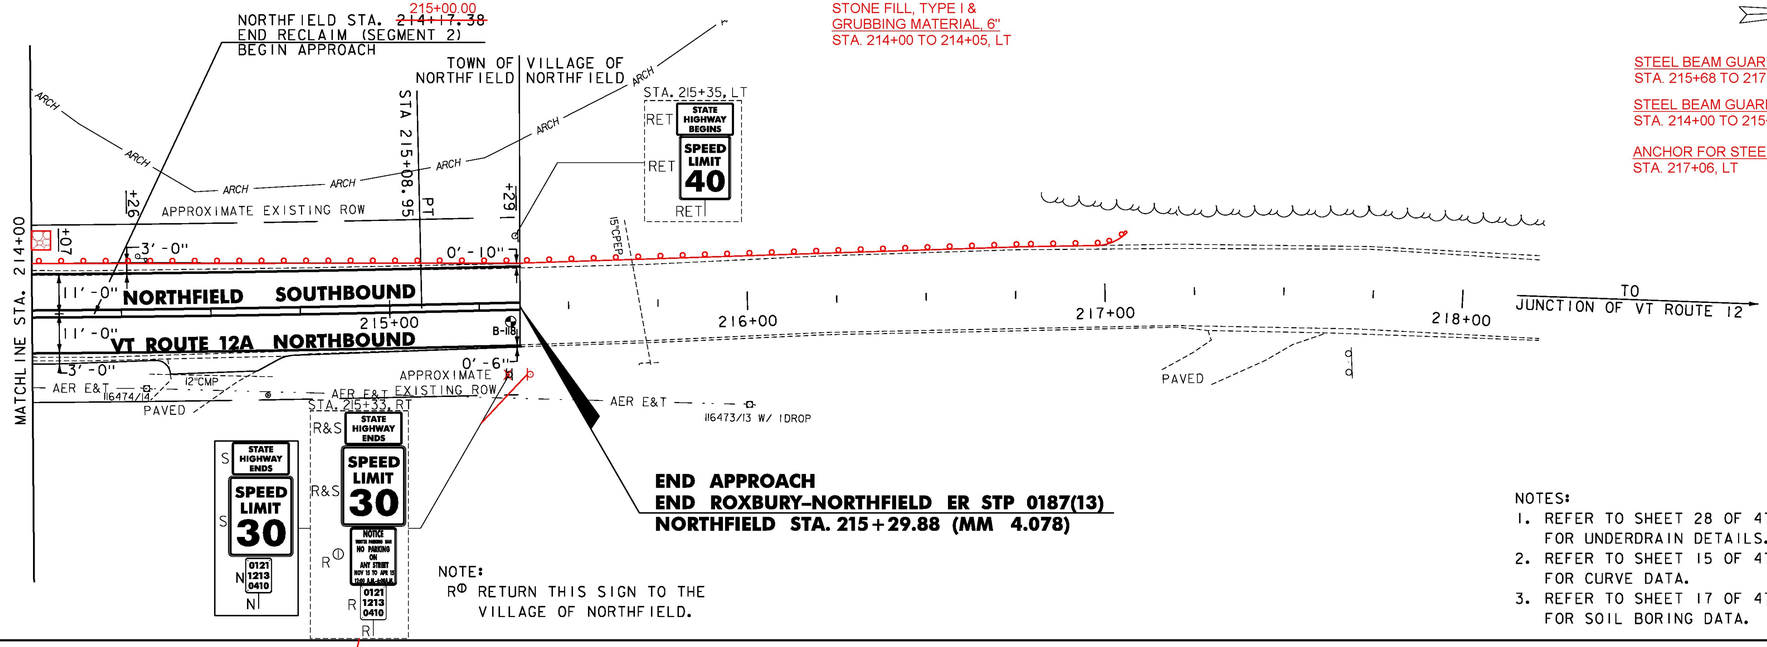

NOTE:
R① RETURN THIS SIGN TO THE VILLAGE OF NORTHFIELD.

SIGN WAS MOVED NORTH 6 FT TO N215+39, RT TO AVOID LEDGE

VT STATE PLANE GRID

STEEL BEAM GUARDRAIL, GALVANIZED
STA. 215+68 TO 217+06, LT

STEEL BEAM GUARDRAIL, GALVANIZED W/ 8' POSTS
STA. 214+00 TO 215+68, LT

ANCHOR FOR STEEL BEAM RAIL
STA. 217+06, LT

NOTES:
1. REFER TO SHEET 28 OF 476 FOR UNDERDRAIN DETAILS.
2. REFER TO SHEET 15 OF 476 FOR CURVE DATA.
3. REFER TO SHEET 17 OF 476 FOR SOIL BORING DATA.

0 20 40
SCALE IN FEET

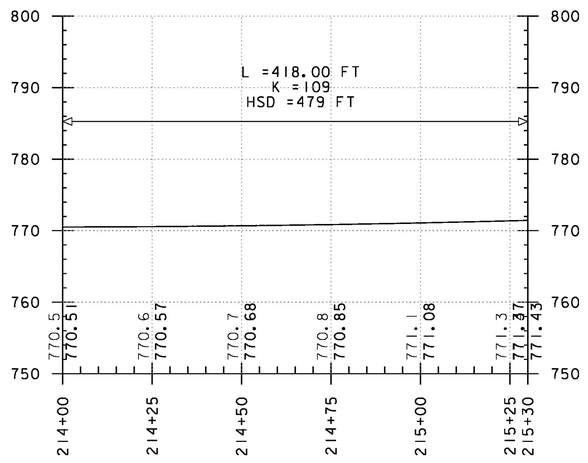

10 5 0 20 40
SCALE IN FEET

Stantec

PROJECT NAME:	ROXBURY - NORTHFIELD
PROJECT NUMBER:	ER STP 0187(13)
FILE NAME: zl3cl84bdr.dgn	PLOT DATE: 5/25/2016
PROJECT LEADER: M. FOISY	DRAWN BY: G. BARRETT
DESIGNED BY: G. BURGMEIER	CHECKED BY: G. EDWARDS
PLAN & PROFILE SHEET 103	SHEET 153 OF 476