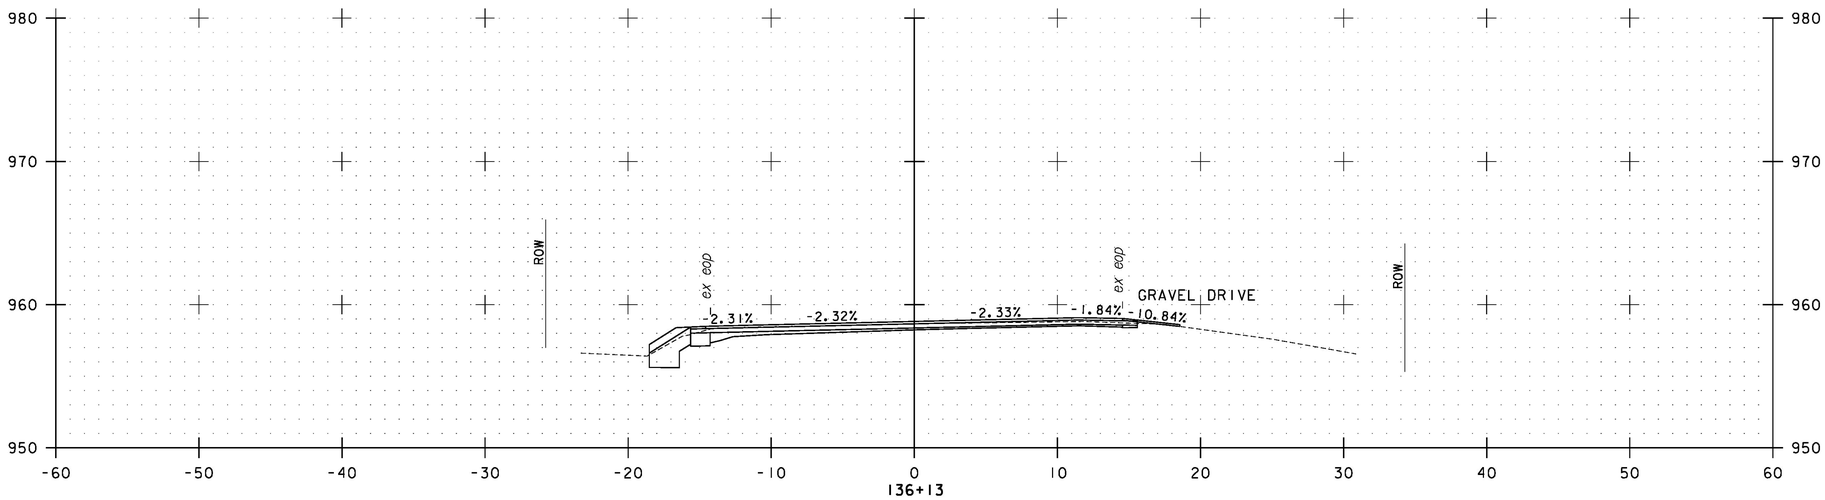


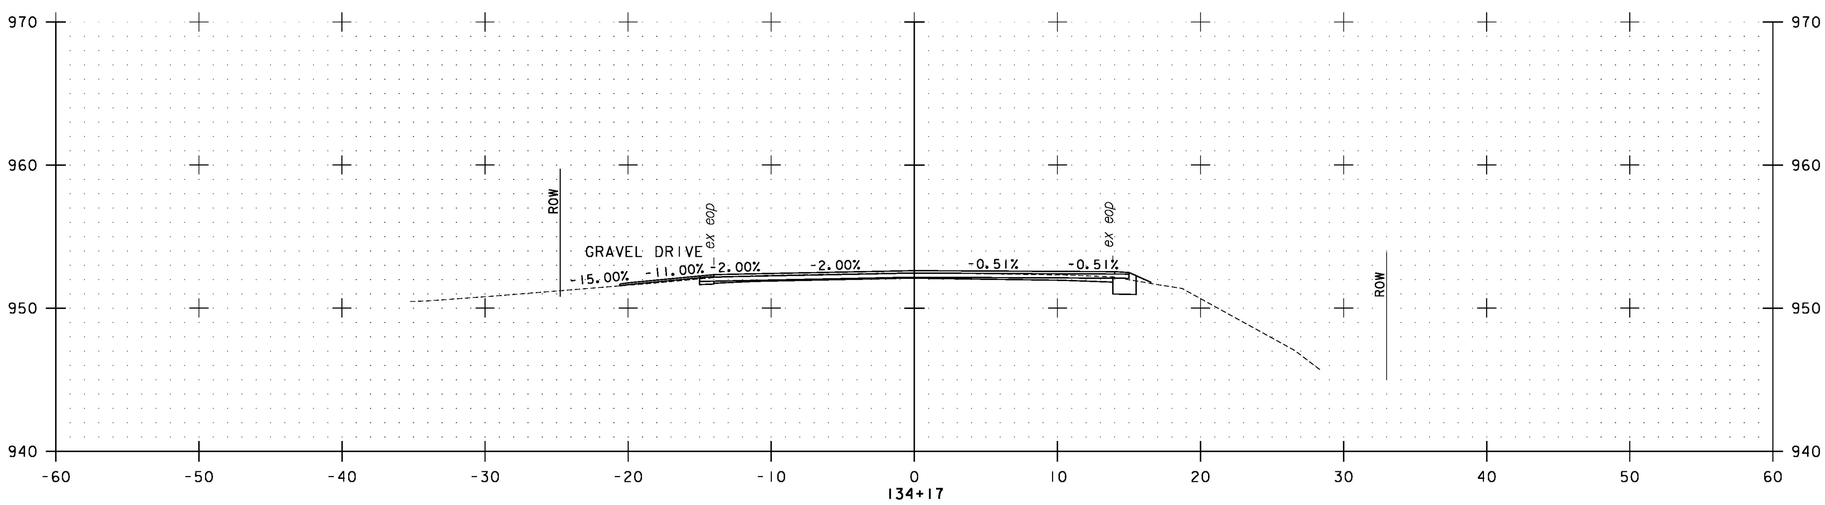


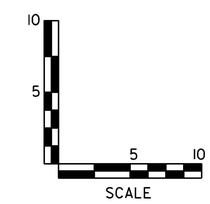


Stantec

| | |
|---|---|
| PROJECT NAME: ROXBURY-NORTHFIELD | |
| PROJECT NUMBER: ER STP 0187(13) | |
| FILE NAME: z13c184xs_drive.dgn | PLOT DATE: 5/25/2016 |
| PROJECT LEADER: M. FOISY | DRAWN BY: G. BURGMEIER |
| DESIGNED BY: G. BURGMEIER | CHECKED BY: M. FOISY |
| **ROXBURY DRIVE SECTIONS SHEET 4** | SHEET 429 OF 476 |