DURABLE 4 INCH WHITE LINE, TYPE A TAPE AND TEMPORARY 4 INCH WHITE LINE, PAINT
(ALL LINES WILL INCLUDE EDGE LINE BREAKS AND RADIUS FOR TOWN HIGHWAYS)
CHESTER:
STA C 235+50.00 - STA C 240+50.00 EDGE LINE LT & RT

DURABLE 4 INCH YELLOW LINE, TYPE A TAPE AND TEMPORARY 4 INCH YELLOW LINE, PAINT
(ALL LINES WILL INCLUDE C/L LINE BREAKS FOR TOWN HIGHWAYS)
S = SOLID, D = DASHED

CHESTER:	LT	℄	RT
STA C 235+50.00 - STA C 240+50.00	S	-	S

DURABLE 8 INCH WHITE LINE, TYPE A TAPE
CHESTER:
STA C 236+81.00 - STA C 236+93.00 RT, FIRE HYDRANT, NO PARKING

DURABLE CROSSWALK MARKING, TYPE A TAPE AND TEMPORARY CROSSWALK MARKING, PAINT
CHESTER:
STA C 239+93.00 LT/RT

REMOVING SIGNS
AS SHOWN - 2

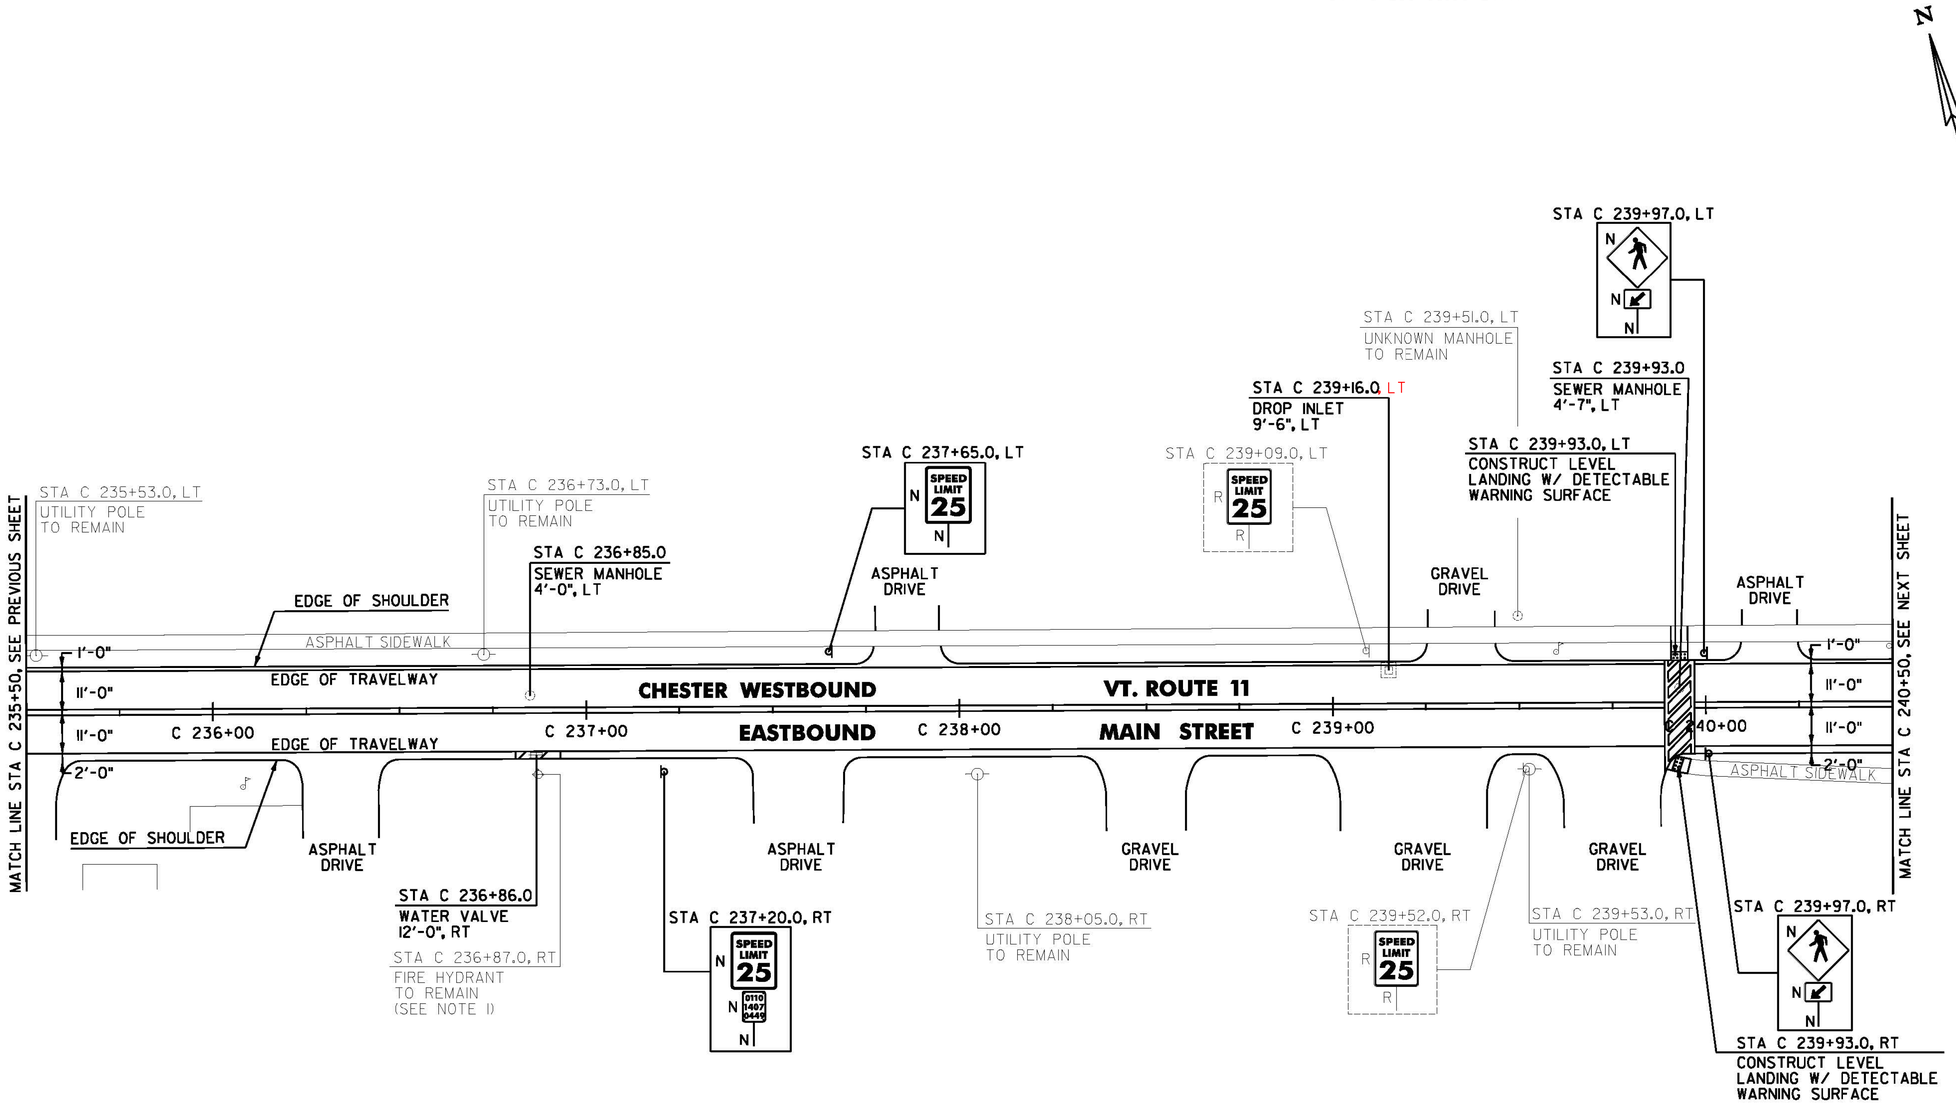

CHANGING ELEVATION OF SEWER MANHOLES
CHESTER:
STA C 236+85.0 LT
STA C 239+93.0 LT

REHAB, DROP INLETS, CATCH BASINS, OR MANHOLES, CLASS I, II, OR III
CHESTER:
STA C 239+16.0 LT

PORTLAND CEMENT CONCRETE SIDEWALK, 5 INCH
CHESTER:
STA C 239+93.0 LT
STA C 239+93.0 RT

ADJUST ELEVATION OF VALVE BOX
CHESTER:
STA C 236+86.0 RT

DETECTABLE WARNING SURFACE
CHESTER:
STA C 239+93.0 LT
STA C 239+93.0 RT

SIGN LEGEND
R = REMOVE
S = SALVAGE
N = NEW
RET = RETAIN
B-B = BACK TO BACK
EXISTING = ----------
NEW = ——————
R = RETURN TO TOWN ⓣ OF CHESTER

NOTE:
1. SEE SHEET 16 FOR FIRE HYDRANT PAVEMENT MARKING DETAIL.

NOT TO SCALE

CHESTER PROJECT LAYOUT SHEET #2

PROJECT NAME: CHESTER-SPRINGFIELD-ROCKINGHAM-WINDSOR
PROJECT NUMBER: STP 2952(1)

FILE NAME: z13c518bdr_seg01.dgn
PROJECT LEADER: D. GOZALKOWSKI
DESIGNED BY: A. HAWKINS
PLOT DATE: 3/27/2015
DRAWN BY: A. KIRBY
CHECKED BY: J. SHIELDS
SHEET 32 OF 309