DURABLE 4 INCH WHITE LINE, TYPE A TAPE AND TEMPORARY 4 INCH WHITE LINE, PAINT
(ALL LINES WILL INCLUDE EDGE LINE BREAKS AND RADIUS FOR TOWN HIGHWAYS)
CHESTER:
STA C 160+25.00 - STA C 165+25.00 EDGE LINE LT & RT

DURABLE 4 INCH YELLOW LINE, TYPE A TAPE AND TEMPORARY 4 INCH YELLOW LINE, PAINT
(ALL LINES WILL INCLUDE C/L LINE BREAKS FOR TOWN HIGHWAYS)
S = SOLID, D = DASHED

CHESTER:	LT	℄	RT
STA C 160+25.00 - STA C 165+25.00	S	-	S

DURABLE 8 INCH WHITE LINE, TYPE A TAPE
CHESTER:
STA C 164+20.00 - STA C 164+32.00 RT, FIRE HYDRANT, NO PARKING

REMOVING SIGNS
AS SHOWN - 3

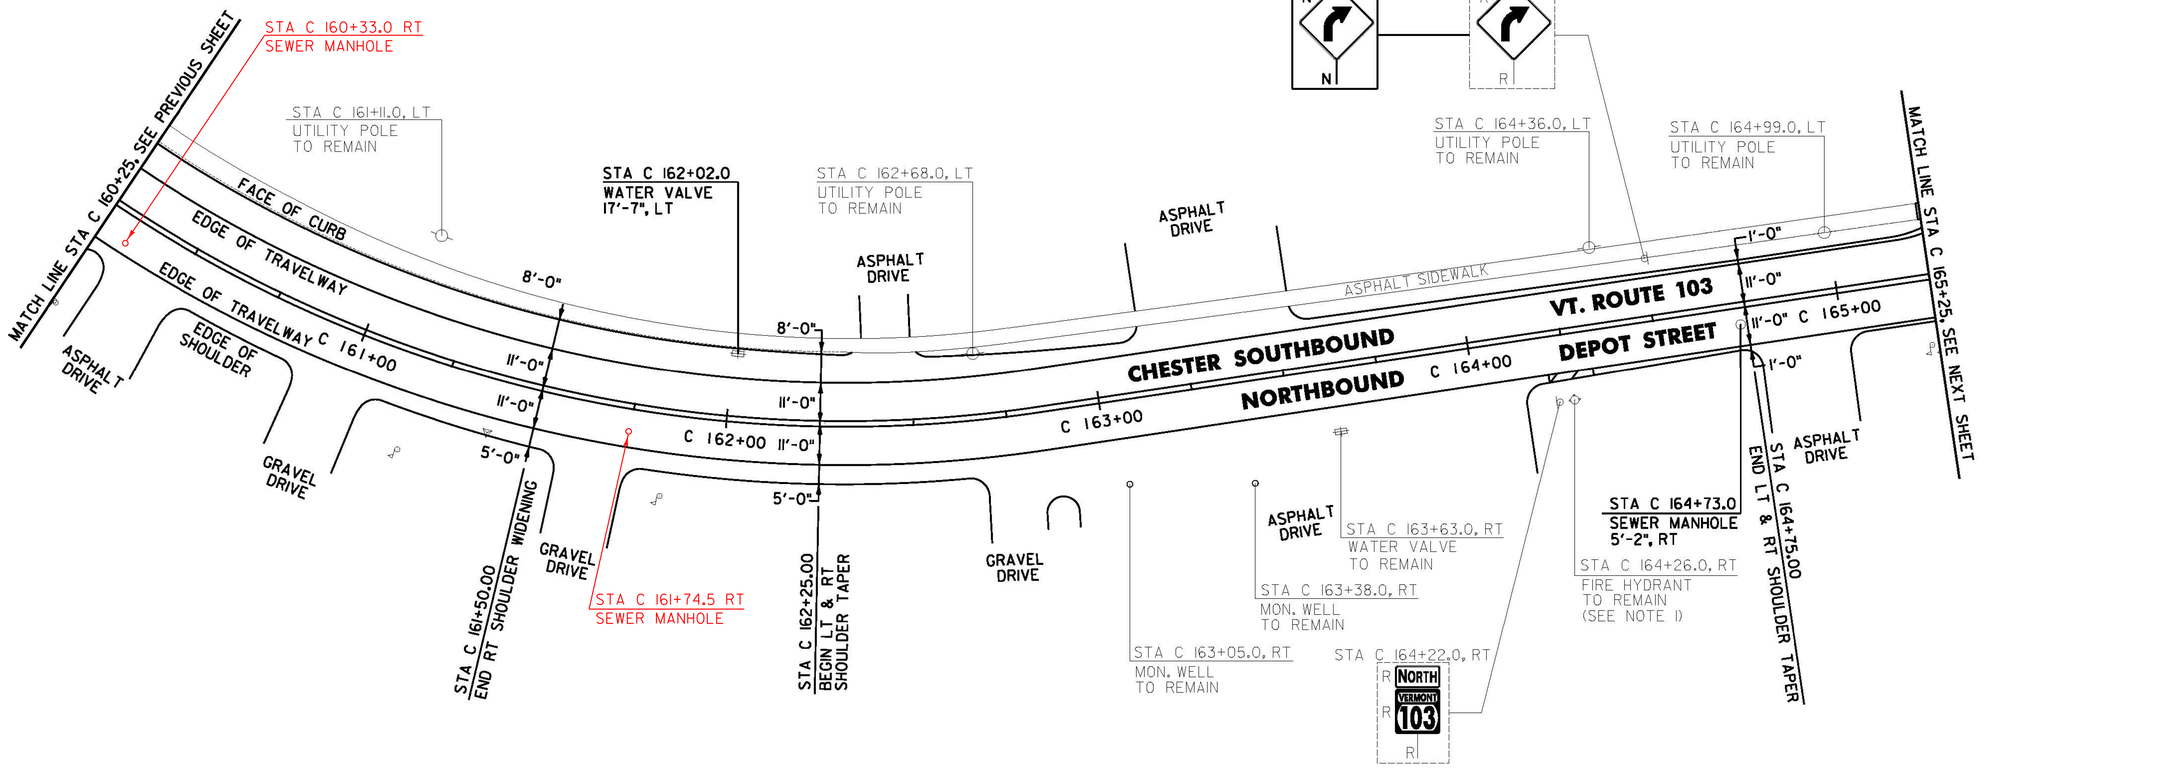

CHANGING ELEVATION OF SEWER MANHOLES
CHESTER:
STA C 164+73.0 RT STA C 161+74.5 RT
STA C 160+33.0 RT
ADJUST ELEVATION OF VALVE BOX
CHESTER:
STA C 162+02.0 LT

SIGN LEGEND
R = REMOVE
S = SALVAGE
N = NEW
RET = RETAIN
B-B = BACK TO BACK
EXISTING = ----------
NEW = ——————
R① = RETURN TO TOWN OF CHESTER

NOTE:
1. SEE SHEET 16 FOR FIRE HYDRANT PAVEMENT MARKING DETAIL.

NOT TO SCALE

CHESTER PROJECT LAYOUT SHEET #16

PROJECT NAME: CHESTER-SPRINGFIELD-ROCKINGHAM-WINDSOR
PROJECT NUMBER: STP 2952(1)

FILE NAME: z13c5i8bdr_seg01.dgn
PROJECT LEADER: D. GOZALKOWSKI
DESIGNED BY: A. HAWKINS
PLOT DATE: 3/27/2015
DRAWN BY: A. KIRBY
CHECKED BY: J. SHIELDS
SHEET 46 OF 309