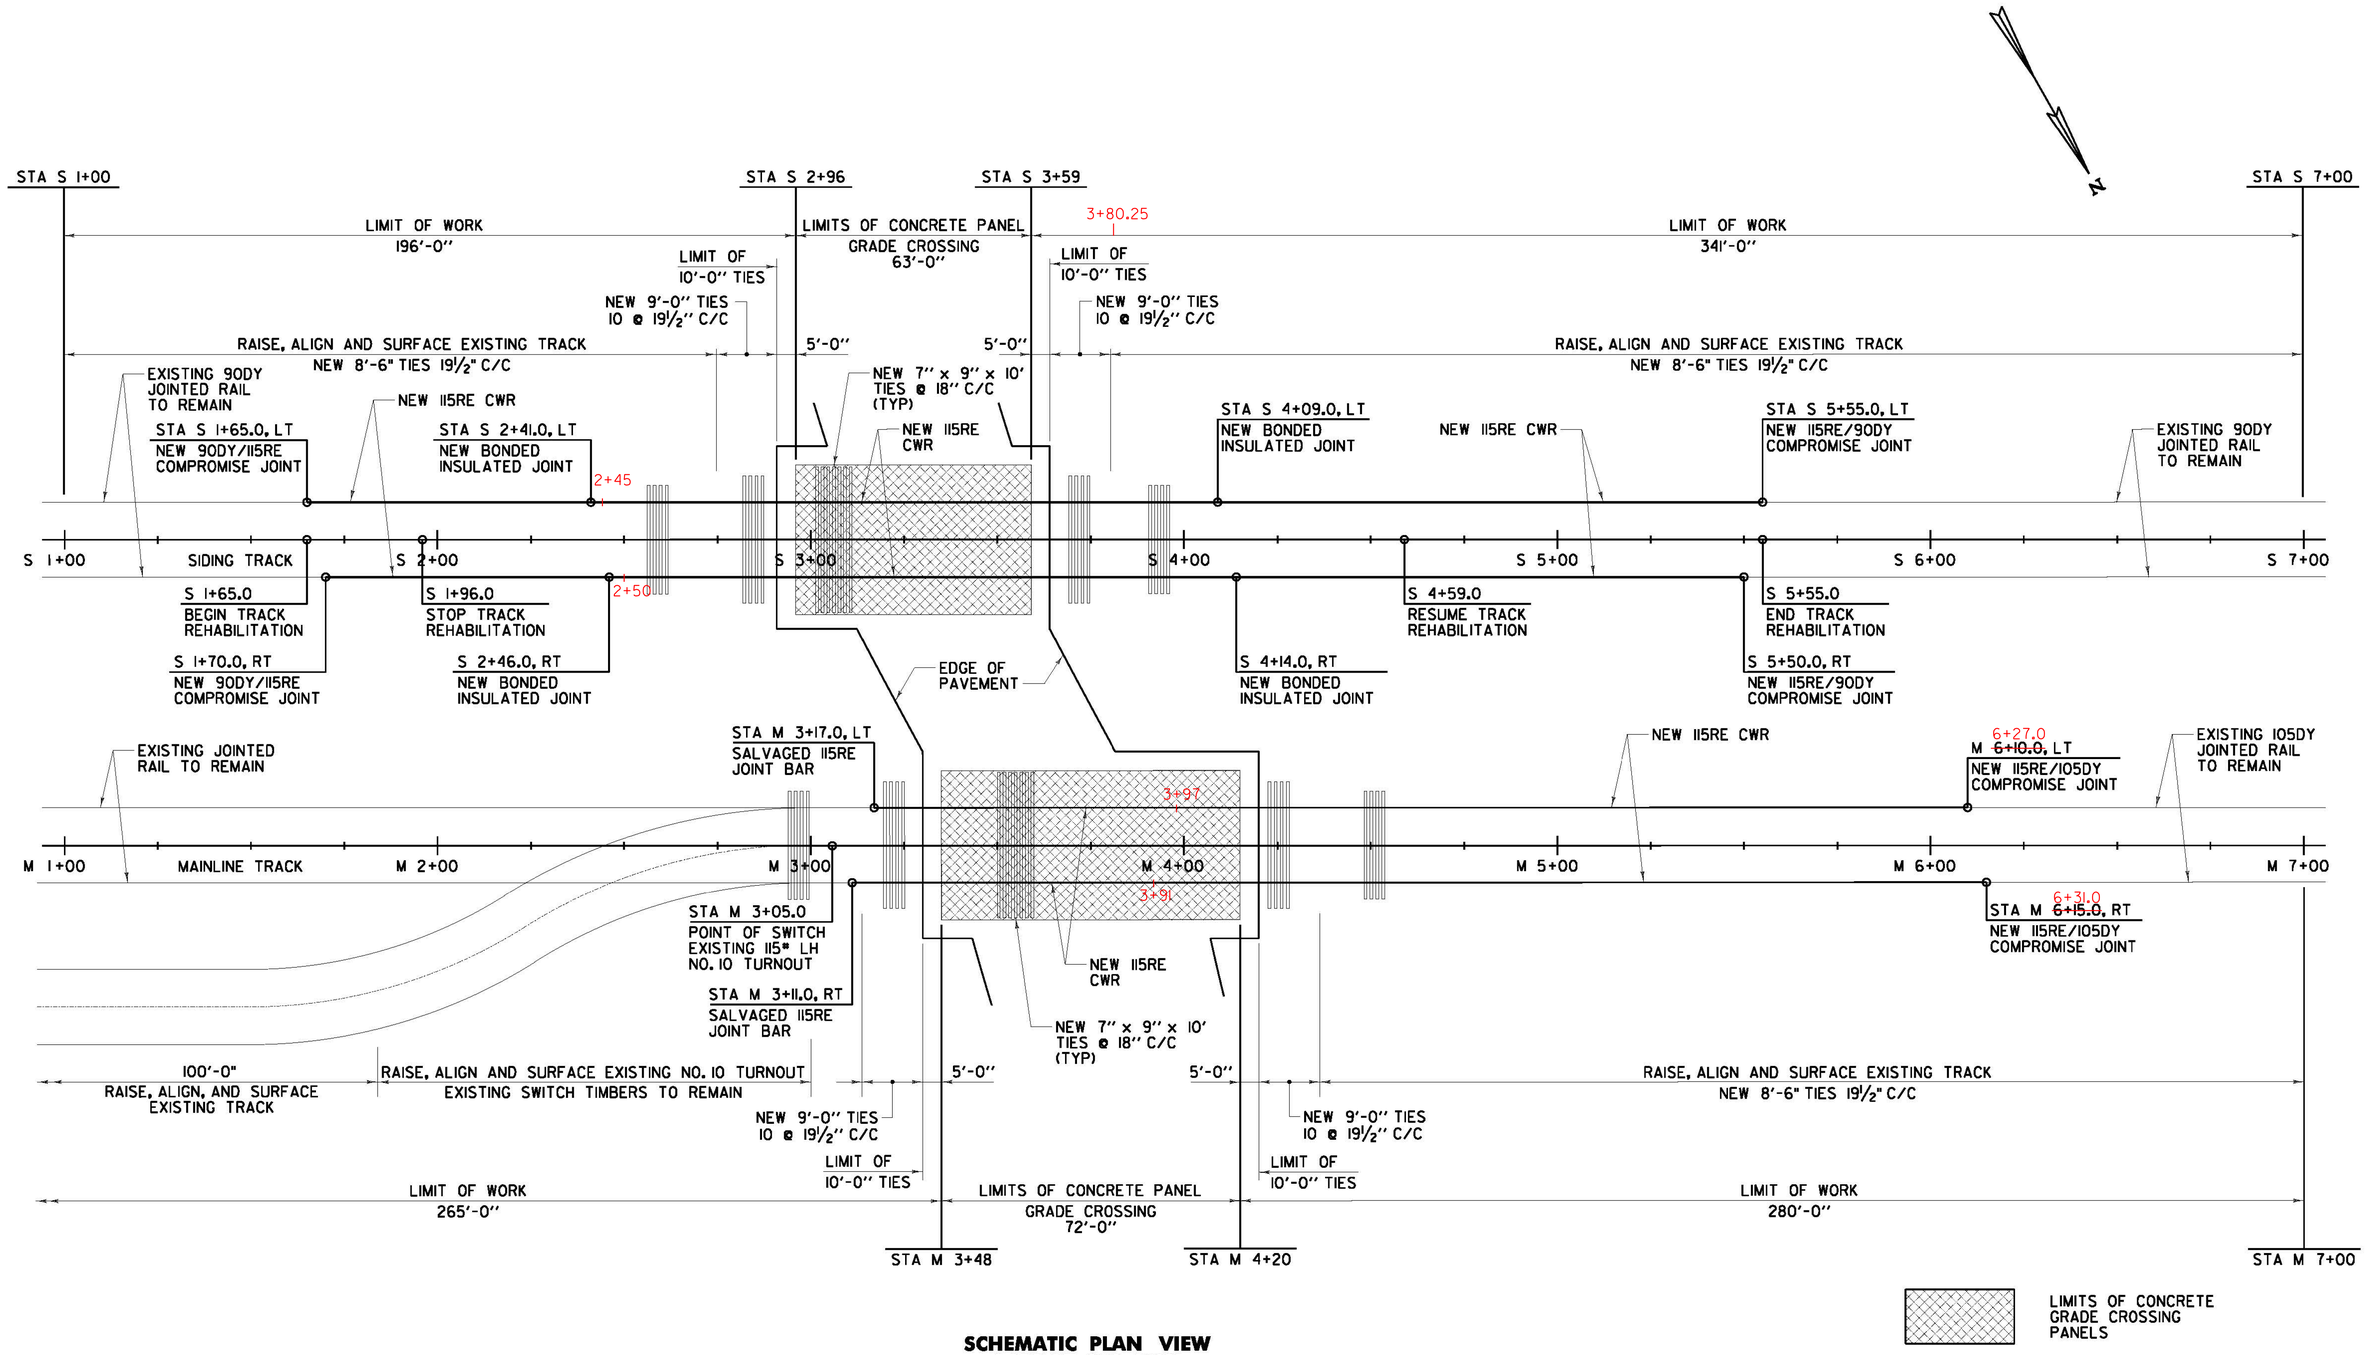

SCHEMATIC PLAN VIEW
AARDOT 859-813N
MP 13.50
HIGHWAY CROSSING

NOT TO SCALE

AARDOT 859-813N SCHEMATIC PLAN SHEET	PROJECT NAME: CHESTER-SPRINGFIELD-ROCKINGHAM-WINDSOR PROJECT NUMBER: STP 2952(1)
	FILE NAME: zl3c518rrschp.dgn PROJECT LEADER: D. GOZALKOWSKI DESIGNED BY: M. MOKEY PLOT DATE: 3/27/2015 DRAWN BY: A. KIRBY CHECKED BY: D. EMERICH SHEET 91 OF 309