DURABLE 4 INCH WHITE LINE, TYPE A TAPE AND TEMPORARY 4 INCH WHITE LINE, PAINT
(ALL LINES WILL INCLUDE EDGE LINE BREAKS AND RADIUS FOR TOWN HIGHWAYS)
ROCKINGHAM:
STA R 39+25.00 - STA R 43+25.00 EDGE LINE LT & RT
STA R 41+39.52 EDGE LINES LT, TH-354

DURABLE 4 INCH YELLOW LINE, TYPE A TAPE AND TEMPORARY 4 INCH YELLOW LINE, PAINT
(ALL LINES WILL INCLUDE C/L LINE BREAKS FOR TOWN HIGHWAYS)
S = SOLID, D = DASHED
ROCKINGHAM: LT ℄ RT
STA R 39+25.00 - STA R 43+25.00 S - S
STA R 41+39.52 DOUBLE SOLID LT, TH-354

DURABLE 24 INCH STOP BAR, TYPE A TAPE AND TEMPORARY 24 INCH STOP BAR, PAINT
ROCKINGHAM:
STA R 41+39.52 LT, TH-354

DURABLE LETTER OR SYMBOL, TYPE D TAPE
ROCKINGHAM:
STA R 39+71.00 LT, "A,H,E,A,D" (5 EA)
STA R 40+03.00 LT, "S,T,O,P" (4 EA)
STA R 41+39.52 LT, TH-354 "S,T,O,P" (4 EA)

TEMPORARY LETTER OR SYMBOL, PAINT
ROCKINGHAM:
STA R 39+71.00 LT, "A,H,E,A,D" (10 EA)
STA R 40+03.00 LT, "S,T,O,P" (8 EA)
STA R 41+39.52 LT, TH-354 "S,T,O,P (8 EA)

DURABLE CROSSWALK MARKING, TYPE A TAPE AND TEMPORARY CROSSWALK MARKING, PAINT
ROCKINGHAM:
STA R 41+27.00 LT/RT
STA R 41+34.24 RT, TH-354
STA R 41+39.52 LT, TH-354

DURABLE 8 INCH WHITE LINE, TYPE A TAPE
ROCKINGHAM:
STA R 41+75.00 - STA R 41+87.00 LT, FIRE HYDRANT, NO PARKING

REMOVING SIGNS
AS SHOWN - 11

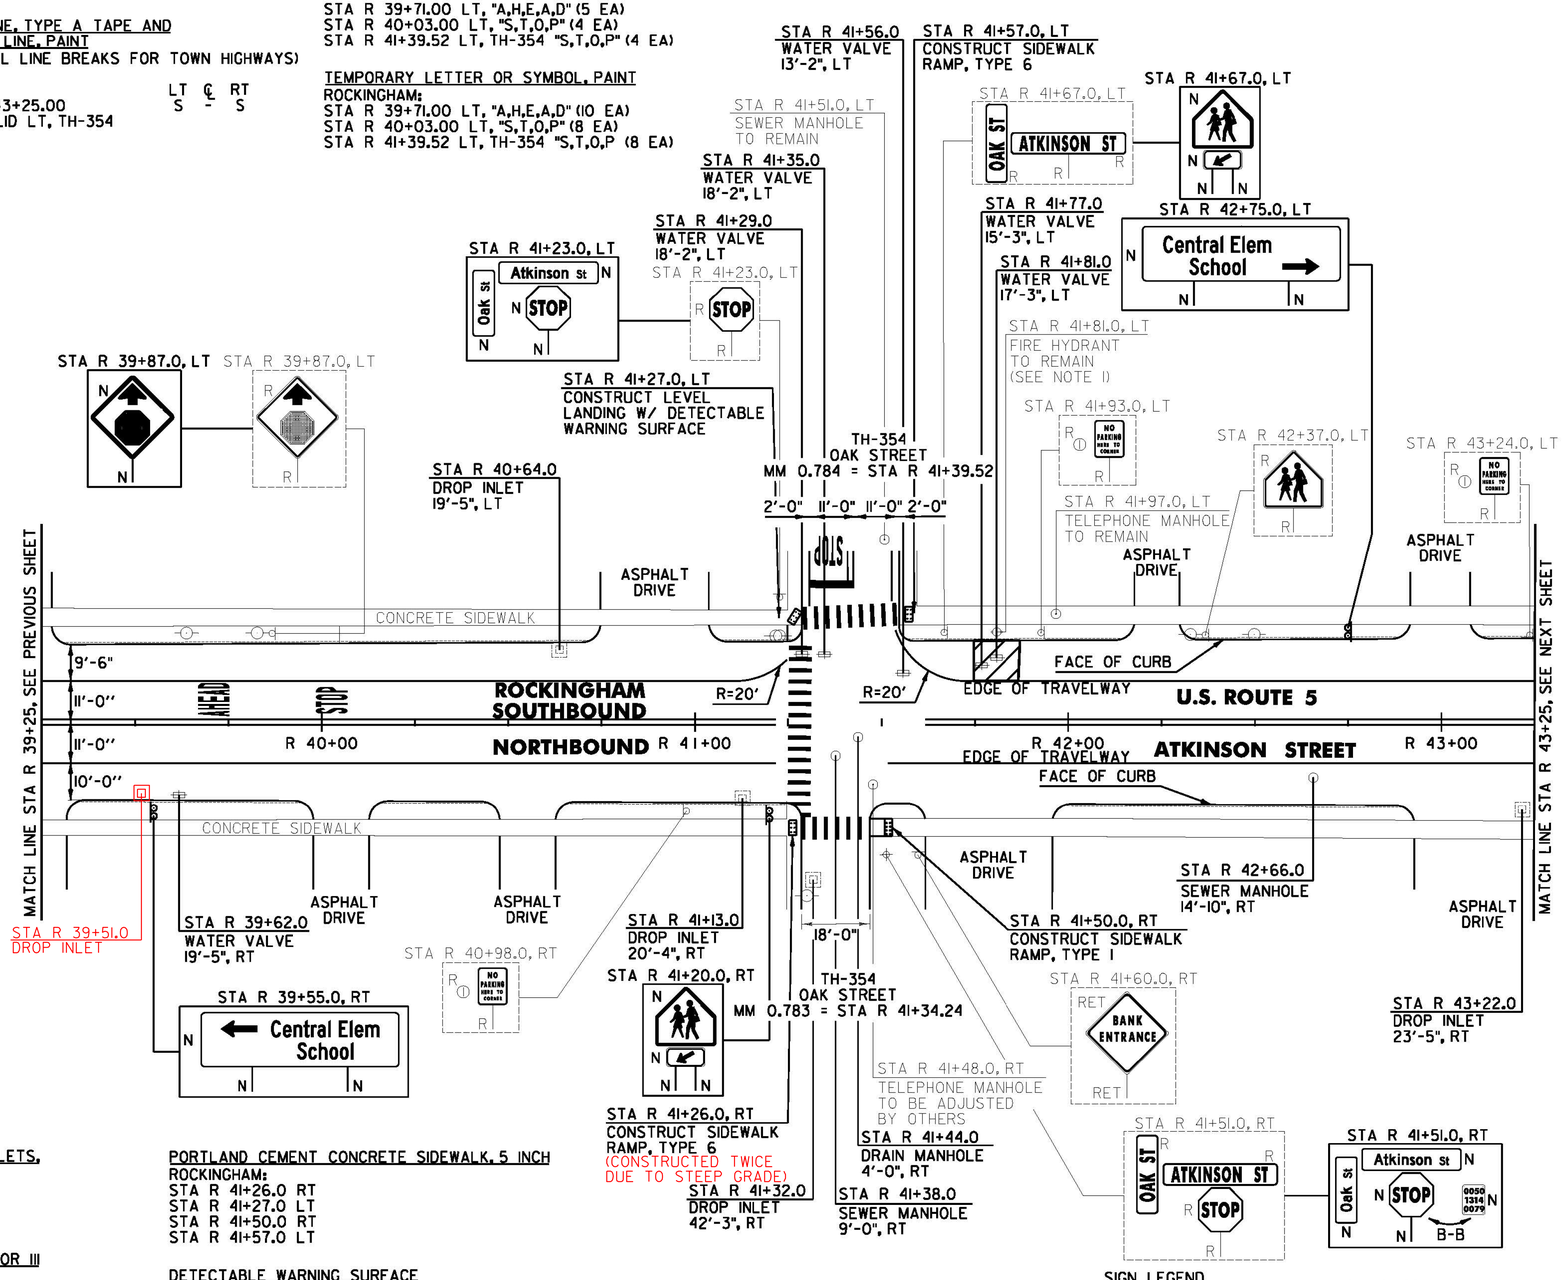

CHANGING ELEVATION OF DROP INLETS, CATCH BASINS, OR MANHOLES
ROCKINGHAM:
STA R 41+44.0 RT

REHAB, DROP INLETS, CATCH BASINS, OR MANHOLES, CLASS I, II OR III
ROCKINGHAM:
STA R 40+64.0 LT STA R 39+51.0 RT
STA R 41+13.0 RT
STA R 41+32.0 RT
STA R 43+22.0 RT

CHANGING ELEVATION OF SEWER MANHOLES
ROCKINGHAM:
STA R 41+38.0 RT
STA R 42+66.0 RT

PORTLAND CEMENT CONCRETE SIDEWALK, 5 INCH
ROCKINGHAM:
STA R 41+26.0 RT
STA R 41+27.0 LT
STA R 41+50.0 RT
STA R 41+57.0 LT

DETECTABLE WARNING SURFACE
ROCKINGHAM:
STA R 41+26.0 RT
STA R 41+27.0 LT
STA R 41+50.0 RT
STA R 41+57.0 LT

REMOVING AND RESETTING CURB
ROCKINGHAM:
STA R 41+57.0 LT

ADJUST ELEVATION OF VALVE BOX
ROCKINGHAM:
STA R 39+62.0 RT
STA R 41+29.0 LT
STA R 41+35.0 LT
STA R 41+56.0 LT
STA R 41+77.0 LT
STA R 41+81.0 LT

SIGN LEGEND
R = REMOVE
S = SALVAGE
N = NEW
RET = RETAIN
B-B = BACK TO BACK
EXISTING = ----------
NEW = ——————
R = RETURN TO TOWN OF ROCKINGHAM

NOTE:
1. SEE SHEET 16 FOR FIRE HYDRANT PAVEMENT MARKING DETAIL.

NOT TO SCALE

ROCKINGHAM PROJECT LAYOUT SHEET #11

PROJECT NAME: CHESTER-SPRINGFIELD-ROCKINGHAM-WINDSOR
PROJECT NUMBER: STP 2952(1)

FILE NAME: z13c518bdr_seg03.dgn
PROJECT LEADER: D. GOZALKOWSKI
DESIGNED BY: A. HAWKINS
PLOT DATE: 3/27/2015
DRAWN BY: A. KIRBY
CHECKED BY: J. SHIELDS
SHEET 189 OF 309