STATE OF VERMONT
AGENCY OF TRANSPORTATION

ROCKINGHAM TRAFFIC SIGN SUMMARY SHEET 17

MILEMARKER, STATION, OR SIGN NUMBER	SIGN LEGEND	SIGN DIMENSIONS EA	WIDTH (In)	HEIGHT (In)	NEW & SALVAGED SIGNS "A"	"B"	SALV SIGN	SALV TIS	EXIST POST RETAIN	EXIST POST SALVAGE	NEW SIGN POSTS NO. OF POSTS	FLANGED CHANNEL lb/ft 1.1	2.0	3.0	SQUARE STEEL (In) lb/ft 1.75 1.88	2.0 2.42	2.5 3.35	ANCHOR	SLEEVE	TUBULAR STEEL Ø (In) FOUND-ATION	lb/ft 3.0 7.6	3.5 9.0	4.0 11	5.0 15	W-SHAPE STEEL FTG. SIZE 24"	30"	WEIGHT	POST SIZE	SIGN FRAME REQUIRED	REMARKS SHSM = FHWA STANDARD HIGHWAY SIGNS AND MARKINGS BOOK	SIGN DETAIL DETAIL IN SHSM	DETAIL ON DWG. NUMBER	STD. SHEET NUMBER
ROCKINGHAM U.S. ROUTE 5: R 65+60.0, LT		1	36	36	9.00						2					X		X													SIGN ID CODE W3-5	X		
R 65+71.0, LT		1 1	30 6	30 10	6.25 0.42						1					X		X													BACK-TO-BACK SIGN ID CODE R1-1 SIGN ID CODE VD-700	X		T-44
R 66+09.0, RT		1 1	30 24	30 30	6.25 5.00						2					X		X													SIGN ID CODE VR-92IL SIGN ID CODE R4-1	X		E-145A
R 66+16.0, LT	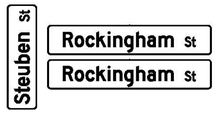	1 1 1	42 66 ~~66~~	12 12 ~~12~~	3.50 5.50 ~~5.50~~						2					X		X													DOUBLE SIDED SIGN, SIGN ID CODE D3-1 BACK-TO-BACK SIGN ID CODE D3-1 SIGN ID CODE D3-1		220 220 220	
																														TOP MOUNTING BRACKETS REQUIRED TO INSTALL SIGNS ON POST. COSTS ASSOCIATED WITH THIS BRACKET ARE INCIDENTAL TO THE SIGN POST.			
R 67+51.0, LT		1	30	30	6.25						1					X		X													SIGN ID CODE W11-8	X		
R 68+26.0, LT		1 1	30 6	30 10	6.25 0.42						1					X		X													BACK-TO-BACK SIGN ID CODE R1-1 SIGN ID CODE VD-700	X		T-44
R 68+61.0, RT		1	30	30	6.25						1					X		X													SIGN ID CODE VR-92IL			E-145A
R 68+70.0, LT		1 1 1	42 66 ~~66~~	12 12 ~~12~~	3.50 5.50 ~~5.50~~						2					X		X													DOUBLE SIDED SIGN, SIGN ID CODE D3-1 BACK-TO-BACK SIGN ID CODE D3-1 SIGN ID CODE D3-1		220 220 220	
																														TOP MOUNTING BRACKETS REQUIRED TO INSTALL SIGNS ON POST. COSTS ASSOCIATED WITH THIS BRACKET ARE INCIDENTAL TO THE SIGN POST.			
												LF	LF	LF	LF	LF 168	LF		EA		LB	LB	LB	LB								
FINAL POST LENGTHS ARE TO BE DETERMINED IN THE FIELD. POST SIZES ARE COMPUTED BASED ON INFORMATION FURNISHED ON THE STANDARD SHEETS AND THE VTRANS "SIGN POST DESIGN GUIDELINE."		TOTALS			SF ~~75.09~~ 64.08	SF	EA.	SF				LF			LF 168					EA.	LB				EA.	EA.	LB						

ROCKINGHAM TRAFFIC SIGN SUMMARY SHEET #17

PROJECT NAME: CHESTER-SPRINGFIELD-ROCKINGHAM-WINDSOR
PROJECT NUMBER: STP 2952(1)

FILE NAME: z13c5181ss_seg03.dgn
PROJECT LEADER: D. GOZALKOWSKI
DESIGNED BY: A. HAWKINS
PLOT DATE: 3/27/2015
DRAWN BY: A. KIRBY
CHECKED BY: J. SHIELDS
SHEET 216 OF 309