

DURABLE 4 INCH WHITE LINE, TYPE A TAPE AND TEMPORARY 4 INCH WHITE LINE, PAINT
 (ALL LINES WILL INCLUDE EDGE LINE BREAKS AND RADIUS FOR TOWN HIGHWAYS)
 WINDSOR:
 STA W 171+01.92 - STA W 175+75.00 EDGE LINE LT & RT
 STA W 171+49.44 EDGE LINES LT, TH-49
 STA W 172+65.60 SOLID LANE LINE LT, TH-45
 STA W 172+65.60 EDGE LINES LT, TH-45

DURABLE 4 INCH YELLOW LINE, TYPE A TAPE AND TEMPORARY 4 INCH YELLOW LINE, PAINT
 (ALL LINES WILL INCLUDE C/L BREAKS FOR TOWN HIGHWAYS)
 S=SOLID D=DASHED
 WINDSOR:
 STA W 171+01.92 - STA W 175+75.00 LT & RT
 STA W 171+49.44 DOUBLE SOLID LT, TH-49



DURABLE LETTER OR SYMBOL, TYPE D TAPE
 WINDSOR:
 STA W 171+49.44 LT, TH-49 "S,T,O,P" (4 EA)
 STA W 172+65.60 LT, TH-45 "S,T,O,P" (4 EA)
 STA W 172+65.60 LT, TH-45 "S,T,O,P" (4 EA)
 STA W 172+65.60 LT, TH-45 ARROW (1EA)
 STA W 172+65.60 LT, TH-45 ARROW (1EA)

TEMPORARY LETTER OR SYMBOL, PAINT
 WINDSOR:
 STA W 171+49.44 LT, TH-49 "S,T,O,P" (8 EA)
 STA W 172+65.60 LT, TH-45 "S,T,O,P" (8 EA)
 STA W 172+65.60 LT, TH-45 "S,T,O,P" (8 EA)
 STA W 172+65.60 LT, TH-45 ARROW (2 EA)
 STA W 172+65.60 LT, TH-45 ARROW (2 EA)

REMOVING SIGNS
 AS SHOWN - 9

ERECTING SALVAGED SIGNS
 AS SHOWN - 6

DURABLE 24 INCH STOP BAR, TYPE A TAPE AND TEMPORARY 24 INCH STOP BAR, PAINT
 WINDSOR:
 STA W 171+49.44 LT, TH-49
 STA W 172+65.60 LT, TH-45

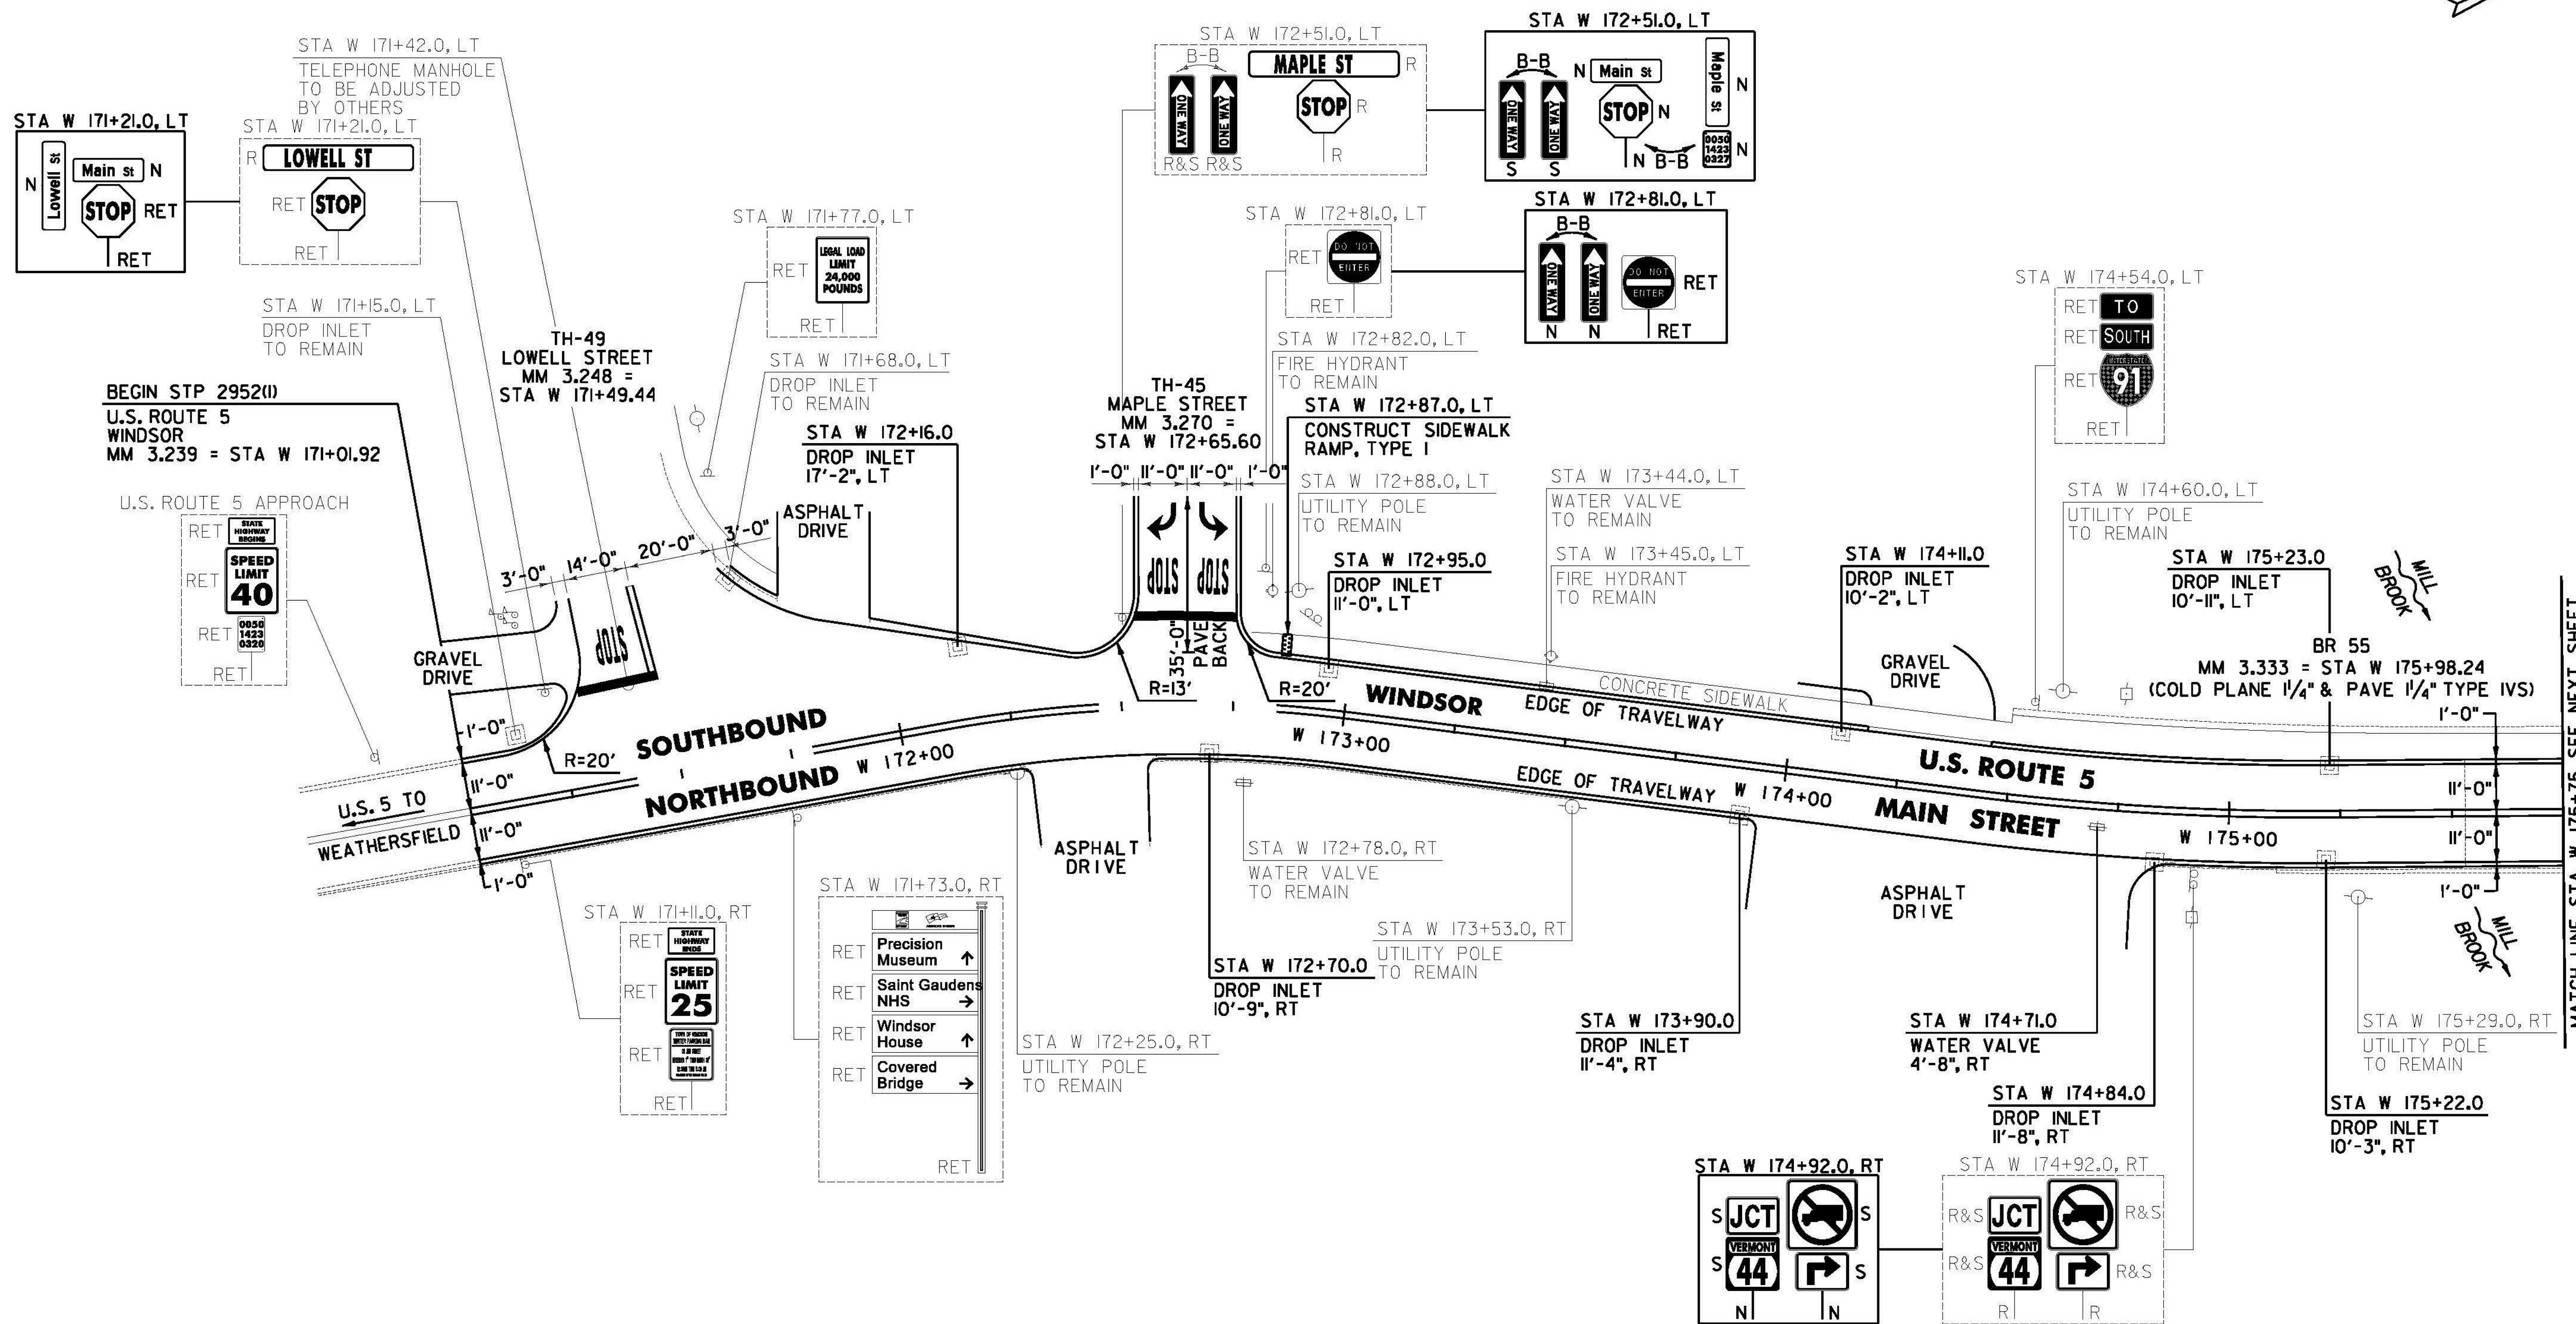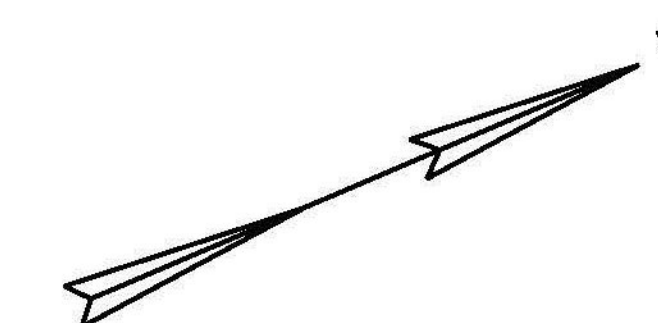

REHAB. DROP INLETS, CATCH BASINS, OR MANHOLES, CLASS I, II, OR III
 WINDSOR:
 STA W 172+16.0 LT
 STA W 172+70.0 RT
 STA W 172+95.0 LT
 STA W 173+90.0 RT
 STA W 174+11.0 LT
 STA W 174+84.0 RT
 STA W 175+22.0 RT
 STA W 175+23.0 LT

PORTLAND CEMENT CONCRETE SIDEWALK, 5 INCH
 WINDSOR:
 STA W 172+87.0 LT
DETECTABLE WARNING SURFACE
 WINDSOR:
 STA W 172+87.0 LT
ADJUST ELEVATION OF VALVE BOX
 WINDSOR:
 STA W 174+71.0 RT

SIGN LEGEND
 R = REMOVE
 S = SALVAGE
 N = NEW
 RET = RETAIN
 B-B = BACK TO BACK
 EXISTING = _____
 NEW = _____
 R = RETURN TO TOWN OF WINDSOR

NOT TO SCALE

WINDSOR PROJECT LAYOUT SHEET #1

PROJECT NAME: CHESTER-SPRINGFIELD-ROCKINGHAM-WINDSOR
 PROJECT NUMBER: STP 2952(I)

FILE NAME: z13c518bdr_seg04.dgn
 PROJECT LEADER: D. GOZALKOWSKI
 DESIGNED BY: A. HAWKINS

PLOT DATE: 3/27/2015
 DRAWN BY: A. KIRBY
 CHECKED BY: J. SHIELDS
 SHEET 237 OF 309