DIRECTION	MILEPOINT	LOCATION CODE (SHEET 3)	SIGN CODE	WIDTH (IN)	HEIGHT (IN)	SHEETING REMARKS	SIGN LEGEND	NEW SIGNS "A"	NEW SIGNS "B"	EXISTING SIGNS RETAIN	EXISTING SIGNS SALVAGE FROM	EXISTING SIGNS SALVAGE TO	EXISTING SIGNS REMOVE	EXIST POST RETAIN	EXIST POST REMOVE	NUMBER OF NEW POSTS	SQUARE STEEL (IN) 1.75 (LB/FT) 1.88	SQUARE STEEL (IN) 2.00 (LB/FT) 2.42	SQUARE STEEL (IN) 2.50 (LB/FT) 3.35	TUBULAR STEEL Ø (IN) FOUNDATION	TUBULAR STEEL Ø (IN) 3.00 (LB/FT) 7.60	TUBULAR STEEL Ø (IN) 3.50 (LB/FT) 9.00	TUBULAR STEEL Ø (IN) 4.00 (LB/FT) 10.80	TUBULAR STEEL Ø (IN) 5.00 (LB/FT) 14.60	SIGN FRAME REQUIRED	REMARKS	SIGN DETAIL LOCATION SHSM	SIGN DETAIL LOCATION PROJECT SHEET #	SIGN DETAIL LOCATION STANDARD SHEET #
NB RANDOLPH VT 12							FY-FLUORESCENT YELLOW FYG-FLUORESCENT YELLOW GREEN									ANCHORS										"SHSM"-STANDARD HIGHWAY SIGNS AND MARKINGS BOOK			
		D	VD1-2	72	20		(CONT.)	10.00								2	FOUNDATION FOR TUBE STEEL			2	207.73 ~~219.7~~					INSTALL NEW SIGN AT SAME LOCATION IN ISLAND FACING WINDOVER RD TRAFFIC		8	
		D	VD1-1A	72	12		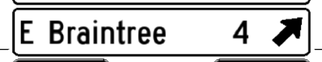	6.00																				8	
		D	M3-3	24	12		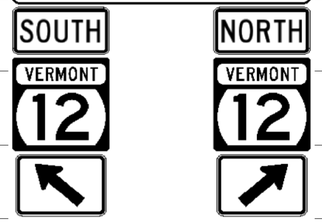	2.00																			SOUTH, **GREEN ON WHITE** INSTALL ON LEFT POST			E-136B
		D	VM1-5	24	24			4.00																			VT ROUTE 12 INSTALL ON LEFT POST			E-136B
		D	M6-2	21	15			2.19																			45 DEG LEFT ARROW, **GREEN ON WHITE** INSTALL ON LEFT POST			E-136B
		D	M3-1	24	12			2.00																			NORTH, **GREEN ON WHITE** INSTALL ON RIGHT POST			E-136B
		D	VM1-5	24	24			4.00																			VT ROUTE 12 INSTALL ON RIGHT POST			E-136B
		D	M6-2	21	15			2.19																			45 DEG RIGHT ARROW, **GREEN ON WHITE** INSTALL ON RIGHT POST			E-136B
NB	3.365	A	W1-6L	48	24		LARGE ARROW LEFT						1		X														
		A	VD-700	6	8		MILE MARKER 0120 / 0909 / 0339						1														MILE MARKER ON LEFT POST			
		A	W1-6L	48	24			8.00								8′ 2	8′-11" 9′-4" X											X		
NB	3.365	B	W1-6R	48	24								1		X												SIGN FACING SOUTHBOUND TRAFFIC			
		B	W1-6R	48	24			8.00								8′ 2	9′-0" 9′-6" X											X		
NB	3.370	D	R1-1	30	30								1		X																
		D	R1-1	30	30			6.25								4′ 1	10′-8" X											X		
SIGN SUMMARY SHEET							SHEET TOTALS	54.63	0.00	0	0	0	4	0	0	7	67′-5" ~~75.0~~			2	207.73 ~~219.7~~	0.0	0.0	0.0					
								SF	SF	EA	EA	EA	EA	EA	EA	EA	FT			EA	LB	LB	LB	LB					
VERMONT AGENCY OF TRANSPORTATION							TOWN DIRECTIONAL TOTALS	177.4	0.0	2	0	0	36	0	0	31	425.0			2	219.7								

PROJECT NAME: **RANDOLPH-BERLIN**
PROJECT NUMBER: **STPG SIGN(52)**

FILE NAME: **z13c626tssrandolph NB** PLOT DATE: **5/12/2015**
PROJECT MANAGER: **C. BEAN** DRAWN BY: **S. GOODWIN**
DESIGNED BY: **S. GOODWIN** CHECKED **D. MUNRO**

RANDOLPH VT-12 NORTHBOUND 3 SHEET **14** OF **105**