DIRECTION	MILEPOINT	LOCATION CODE (SHEET 3)	SIGN CODE	WIDTH (IN)	HEIGHT (IN)	SHEETING REMARKS	SIGN LEGEND	NEW SIGNS "A"	NEW SIGNS "B"	EXISTING SIGNS RETAIN	EXISTING SIGNS SALVAGE FROM	EXISTING SIGNS SALVAGE TO	EXISTING SIGNS REMOVE	EXIST POST RETAIN	EXIST POST REMOVE	NUMBER OF NEW POSTS	SQUARE STEEL (IN) 1.75 (LB / FT) 1.88	SQUARE STEEL (IN) 2.00 (LB / FT) 2.42	SQUARE STEEL (IN) 2.50 (LB / FT) 3.35	TUBULAR STEEL Ø (IN) FOUNDATION	TUBULAR STEEL Ø (IN) 3.00 (LB / FT) 7.60	TUBULAR STEEL Ø (IN) 3.50 (LB / FT) 9.00	TUBULAR STEEL Ø (IN) 4.00 (LB / FT) 10.80	TUBULAR STEEL Ø (IN) 5.00 (LB / FT) 14.60	SIGN FRAME REQUIRED	REMARKS	SIGN DETAIL LOCATION SHSM	SIGN DETAIL LOCATION PROJECT SHEET #	SIGN DETAIL LOCATION STANDARD SHEET #
NB RANDOLPH VT 12							FY-FLUORESCENT YELLOW FYG-FLUORESCENT YELLOW GREEN									ANCHORS										"SHSM"-STANDARD HIGHWAY SIGNS AND MARKINGS BOOK			
NB	4.131	A	VW-202	30	30		TRUCKS ENTERING						1		X													
NB	4.901	A	W2-2LM	30	30		LEFT SIDE ROAD						1		X													
		A	W2-2LM	30	30		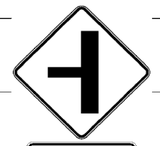	6.25								4′ 1		10′-2" X										E-155
		A	W16-8p	21	8		Peth Rd	1.17																			7	
NB	5.401	A	VD-701	6	10		BRIDGE 44 VT-12	0.42								4′ 1	7′-1" X											T-42
NB	5.508	A	W8-1	30	30								1		X											RETURN TO DISTRICT 4			
		A	W8-1	30	30		BUMP	6.25								4′ 1		10′-5" X									X	
NB	5.591	A	S3-2	30	30		SCHOOL BUS TURN AROUND						1		X													
		A	W16-2aP	24	18		800 FT						1															
		A	VS3-4	30	30	FYG		6.25								4′ 1		11′-0" X										7	
		A	W16-2aP	24	12	FYG	SCHOOL BUS TURN AROUND 800 FT	2.00																			X	
NB	5.985	A	W1-2R	30	30		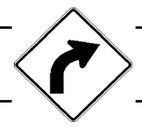	6.25								4′ 1		12′-6" X								INSTALL 200 FT ± SOUTH OF EXISTING SIGN AT MP 6.023	X	
NB	6.023	A	VW-054R	30	30		HIDDEN DRIVE RIGHT						1		X													
NB	6.085	A	VW-054R	30	30			6.25								4′ 1		8′-2" X								INSTALL 325 FT ± NORTH OF EXISTING SIGN AT MP 6.023			E-154
							SHEET TOTALS	34.84	0.00	0	0	0	6	0	0	6		83′-4" ~~85.0~~		0	0.0	0.0	0.0	0.0				
								SF	SF	EA	EA	EA	EA	EA	EA	EA		FT		EA	LB	LB	LB	LB				
							TOWN DIRECTIONAL TOTALS	177.4	0.0	2	0	0	36	0	0	31		425.0		2		219.7						

SIGN SUMMARY SHEET

VERMONT AGENCY OF TRANSPORTATION

PROJECT NAME: RANDOLPH-BERLIN
PROJECT NUMBER: STPG SIGN(52)

FILE NAME: z13c626tssrandolph NB
PROJECT MANAGER: C. BEAN
DESIGNED BY: S. GOODWIN
RANDOLPH VT-12 NORTHBOUND 5

PLOT DATE: 5/12/2015
DRAWN BY: S. GOODWIN
CHECKED BY: D. MUNRO