DIRECTION	MILEPOINT	LOCATION CODE (SHEET 3)	SIGN CODE	WIDTH (IN)	HEIGHT (IN)	SHEETING REMARKS	SIGN LEGEND	NEW SIGNS "A"	NEW SIGNS "B"	EXISTING SIGNS RETAIN	EXISTING SIGNS SALVAGE FROM	EXISTING SIGNS SALVAGE TO	EXISTING SIGNS REMOVE	EXIST POST RETAIN	EXIST POST REMOVE	NUMBER OF NEW POSTS	SQUARE STEEL (IN) 1.75 (LB / FT) 1.88	SQUARE STEEL (IN) 2.00 (LB / FT) 2.42	SQUARE STEEL (IN) 2.50 (LB / FT) 3.35	TUBULAR STEEL Ø (IN) FOUNDATION	TUBULAR STEEL Ø (IN) 3.00 (LB / FT) 7.60	TUBULAR STEEL Ø (IN) 3.50 (LB / FT) 9.00	TUBULAR STEEL Ø (IN) 4.00 (LB / FT) 10.80	TUBULAR STEEL Ø (IN) 5.00 (LB / FT) 14.60	SIGN FRAME REQUIRED	REMARKS	SIGN DETAIL LOCATION SHSM	SIGN DETAIL LOCATION PROJECT SHEET #	SIGN DETAIL LOCATION STANDARD SHEET #
SB RANDOLPH VT 12							FY-FLUORESCENT YELLOW FYG-FLUORESCENT YELLOW GREEN									ANCHORS										"SHSM"-STANDARD HIGHWAY SIGNS AND MARKINGS BOOK			
		F	M3-3	24	12		SOUTH (CONT.)						1																
		F	VM1-5	24	24		VERMONT 12						1																
		F	M6-2	21	15		RIGHT ---> (45 DEG)						1																
		F	VD1-1A	72	12		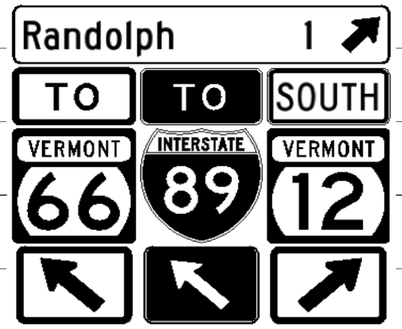	6.00								2	FOUNDATION FOR TUBE STEEL			2	11'-10" 11'-9" 179.23 ~~193.8~~						8	
		F	M4-5	24	12			2.00																	3A	TO, **GREEN ON WHITE**			E-136B
		F	VM1-5	24	24			4.00																		VT ROUTE 66			E-136B
		F	M6-2	21	15			2.19																		45 DEG LEFT ARROW, **GREEN ON WHITE**			E-136B
		F	M4-5	24	12			2.00																		TO, **WHITE ON BLUE**	X		
		F	M1-1	24	24			4.00																		INTERSTATE 89	X		
		F	M6-2	21	15			2.19																		45 DEG LEFT ARROW, **WHITE ON BLUE**	X		
		F	M3-3	24	12			2.00																		SOUTH, **GREEN ON WHITE**			E-136B
		F	VM1-5	24	24			4.00																		VT ROUTE 12			E-136B
		F	M6-2	21	15			2.19																		45 DEG RIGHT ARROW, **GREEN ON WHITE**			E-136B
SB	3.328	F	M3-3	24	12		SOUTH						1		X														
		F	VM1-5	24	24		VERMONT 12 (CONT. ON NEXT SHEET)						1																
							SHEET TOTALS	30.57	0.00	0	0	0	5	0	0	2		0.0		2	~~179.23~~ ~~193.8~~	0.0	0.0	0.0					
								SF	SF	EA	EA	EA	EA	EA	EA	EA		FT		EA	LB	LB	LB	LB					
							TOWN DIRECTIONAL TOTALS	147.3	0.0	2	0	0	34	0	0	26		345.0		2		193.8							

SIGN SUMMARY SHEET

VERMONT AGENCY OF TRANSPORTATION

PROJECT NAME: **RANDOLPH-BERLIN**
PROJECT NUMBER: **STPG SIGN(52)**
FILE NAME: **z13c626tssrandolph SB**
PROJECT MANAGER: **C. BEAN**
DESIGNED BY: **S. GOODWIN**
RANDOLPH VT-12 SOUTHBOUND 4
PLOT DATE: **5/12/2015**
DRAWN BY: **S. GOODWIN**
CHECKED **D. MUNRO**
SHEET **21** OF **105**