DIRECTION	MILEPOINT	LOCATION CODE (SHEET 3)	SIGN CODE	WIDTH (IN)	HEIGHT (IN)	SHEETING REMARKS	SIGN LEGEND	NEW SIGNS "A"	NEW SIGNS "B"	EXISTING SIGNS RETAIN	EXISTING SIGNS SALVAGE FROM	EXISTING SIGNS SALVAGE TO	EXISTING SIGNS REMOVE	EXIST POST RETAIN	EXIST POST REMOVE	NUMBER OF NEW POSTS	SQUARE STEEL (IN) 1.75 (LB / FT) 1.88	SQUARE STEEL (IN) 2.00 (LB / FT) 2.42	SQUARE STEEL (IN) 2.50 (LB / FT) 3.35	FOUNDATION	TUBULAR STEEL Ø (IN) 3.00 (LB / FT) 7.60	TUBULAR STEEL Ø (IN) 3.50 (LB / FT) 9.00	TUBULAR STEEL Ø (IN) 4.00 (LB / FT) 10.80	TUBULAR STEEL Ø (IN) 5.00 (LB / FT) 14.60	SIGN FRAME REQUIRED	REMARKS	SIGN DETAIL LOCATION SHSM	SIGN DETAIL LOCATION PROJECT SHEET #	SIGN DETAIL LOCATION STANDARD SHEET #
SB BRAINTREE VT 12							FY-FLUORESCENT YELLOW FYG-FLUORESCENT YELLOW GREEN									ANCHORS										"SHSM"-STANDARD HIGHWAY SIGNS AND MARKINGS BOOK			
SB	0.902	H	R1-1	30	30								1		X											FARNSWORTH BROOK RD (TH-6)			
		H	R1-1	30	30			6.25								4′ 1		9′-4" X									X		
SB	0.902	F	W1-6L	48	24								1		X														
		F	W1-6L	48	24			8.00								8′ 2		8′-9" 8′-10" X									X		
SB	0.902	E	W1-6R	48	24		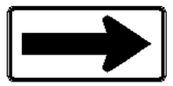						1		X											SIGN FACING NORTHBOUND TRAFFIC			
		E	W1-6R	48	24			8.00								8′ 2		8′-9" 8′-9" X									X		
SB	0.897	G	VR-017	24	30								1		X											EXISTING SIGNS ARE 91.5 FT ± BEYOND SCHOOL SIGN ON FARNSWORTH BROOK RD			
		G	R2-1	18	24								1																
		G	VR-017	24	30			5.00								4′ 1		10′-10" X								INSTALL NEW SIGNS AT SAME LOCATION ON FARNSWORTH BROOK RD			E-141
		G	R2-1	24	30			5.00																			X		
SB	0.893	G	S1-1	30	30		SCHOOL CROSSING						1		X											FARNSWORTH BROOK RD (TH-6)			
SB	0.893	EF	D3-1	48	12		Farnsworth						1		X														
		EF	D3-1	72	12		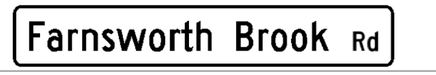	6.00									8′ 2		7′-4" 7′-4" X							INSTALL ON TWO POSTS IN SAME LOCATION AS EXISTING SIGN		10	
							SHEET TOTALS	38.25	0.00	0	0	0	7	0	0	8		101′-11" ~~120.0~~		0	0.0	0.0	0.0	0.0					
								SF	SF	EA	EA	EA	EA	EA	EA	EA		FT		EA	LB	LB	LB	LB					
							TOWN DIRECTIONAL TOTALS	121.7	0.0	0	0	0	27	0	0	24		345.0		0	0.0								

SIGN SUMMARY SHEET

VERMONT AGENCY OF TRANSPORTATION

PROJECT NAME: RANDOLPH-BERLIN
PROJECT NUMBER: STPG SIGN(52)

FILE NAME: z13c626tss braintree SB
PROJECT MANAGER: C. BEAN
DESIGNED BY: S. GOODWIN
BRAINTREE VT-12 SOUTHBOUND 2

PLOT DATE: 5/12/2015
DRAWN BY: S. GOODWIN
CHECKED D. MUNRO