DIRECTION	MILEPOINT	LOCATION CODE (SHEET 3)	SIGN CODE	WIDTH (IN)	HEIGHT (IN)	SHEETING REMARKS	SIGN LEGEND	NEW SIGNS "A"	NEW SIGNS "B"	EXISTING SIGNS RETAIN	EXISTING SIGNS SALVAGE FROM	EXISTING SIGNS SALVAGE TO	EXISTING SIGNS REMOVE	EXIST POST RETAIN	EXIST POST REMOVE	NUMBER OF NEW POSTS	SQUARE STEEL (IN) 1.75 (LB/FT) 1.88	SQUARE STEEL (IN) 2.00 (LB/FT) 2.42	SQUARE STEEL (IN) 2.50 (LB/FT) 3.35	TUBULAR STEEL Ø (IN) FOUNDATION	TUBULAR STEEL Ø (IN) 3.00 (LB/FT) 7.60	TUBULAR STEEL Ø (IN) 3.50 (LB/FT) 9.00	TUBULAR STEEL Ø (IN) 4.00 (LB/FT) 10.80	TUBULAR STEEL Ø (IN) 5.00 (LB/FT) 14.60	SIGN FRAME REQUIRED	REMARKS	SIGN DETAIL LOCATION SHSM	SIGN DETAIL LOCATION PROJECT SHEET #	SIGN DETAIL LOCATION STANDARD SHEET #
SB BRAINTREE VT 12							FY-FLUORESCENT YELLOW FYG-FLUORESCENT YELLOW GREEN									ANCHORS										"SHSM"-STANDARD HIGHWAY SIGNS AND MARKINGS BOOK			
SB	0.885	H	R1-1	30	30		STOP						1		X														
		H	R1-1	30	30			6.25								4′ 1		10′-7" X								X		
		G	VD-700	6	10		0120 0909 0092	0.42																					T-44
SB	0.878	F	VD-701	6	8								1		X														
		F	VD-701	6	10		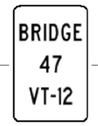	0.42								4′ 1	4′-10" X											T-42
SB	0.744	F	R2-1	24	30		SPEED LIMIT 50						1		X														
SB	0.730	F	R2-1	24	30			5.00								4′ 1		12′-11" X								CERTIFICATE IS MP 0.730. PLACE NEW SIGN 70 FT ± SOUTH OF EXISTING SPEED LIMIT 50 SIGN.	X		
SB	0.676	F	W1-10	30	30		MODIFIED RIGHT CURVE						1		X														
		F	W13-1P	18	18		35 M.P.H. (PLAQUE)						1																
		F	W1-10	36	36		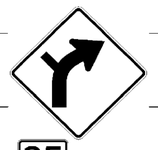	9.00								8′ 2		12′-5" 11′-3" X									X	
		F	W13-1P	18	18			2.25																		INSTALL ON LEFT POST	X		
SB	0.625	F	VW-054R	30	30		HIDDEN DRIVE RIGHT						1		X														
SB	0.587	F	VW-054R	30	30			6.25								4′ 1		11′-2" X								INSTALL 200 FT ± SOUTH OF EXISTING SIGN AT MP 0.625			E-154
SB	0.570	F	VD-701	6	8								1		X														
		F	VD-701	6	10		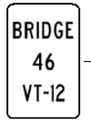	0.42								4′ 1	4′-10" X											T-42
							SHEET TOTALS	30.01	0.00	0	0	0	7	0	0	7		96′-0" ~~95.0~~		0	0.0	0.0	0.0	0.0					
								SF	SF	EA	EA	EA	EA	EA	EA	EA		FT		EA	LB	LB	LB	LB					
							TOWN DIRECTIONAL TOTALS	121.7	0.0	0	0	0	27	0	0	24		345.0		0		0.0							

SIGN SUMMARY SHEET

VERMONT AGENCY OF TRANSPORTATION

PROJECT NAME: **RANDOLPH-BERLIN**
PROJECT NUMBER: **STPG SIGN(52)**

FILE NAME: **z13c626tssbraintree SB**
PROJECT MANAGER: **C. BEAN**
DESIGNED BY: **S. GOODWIN**
BRAINTREE VT-12 SOUTHBOUND 3

PLOT DATE: **5/12/2015**
DRAWN BY: **S. GOODWIN**
CHECKED **D. MUNRO**