DIRECTION	MILEPOINT	LOCATION CODE (SHEET 3)	SIGN CODE	WIDTH (IN)	HEIGHT (IN)	SHEETING REMARKS	SIGN LEGEND	NEW SIGNS "A"	NEW SIGNS "B"	EXISTING SIGNS RETAIN	EXISTING SIGNS SALVAGE FROM	EXISTING SIGNS SALVAGE TO	EXISTING SIGNS REMOVE	EXIST POST RETAIN	EXIST POST REMOVE	NUMBER OF NEW POSTS	SQUARE STEEL (IN) 1.75 (LB / FT) 1.88	SQUARE STEEL (IN) 2.00 (LB / FT) 2.42	SQUARE STEEL (IN) 2.50 (LB / FT) 3.35	FOUNDATION	TUBULAR STEEL Ø (IN) 3.00 (LB / FT) 7.60	TUBULAR STEEL Ø (IN) 3.50 (LB / FT) 9.00	TUBULAR STEEL Ø (IN) 4.00 (LB / FT) 10.80	TUBULAR STEEL Ø (IN) 5.00 (LB / FT) 14.60	SIGN FRAME REQUIRED	REMARKS	SIGN DETAIL LOCATION SHSM	SIGN DETAIL LOCATION PROJECT SHEET #	SIGN DETAIL LOCATION STANDARD SHEET #
SB BROOKFIELD VT 12							FY-FLUORESCENT YELLOW FYG-FLUORESCENT YELLOW GREEN									ANCHORS										"SHSM"-STANDARD HIGHWAY SIGNS AND MARKINGS BOOK			
SB	5.451	F	W1-10	30	30		MODIFIED RIGHT CURVE						1		X														
		F	W13-1P	18	18		40 MPH						1																
SB	5.374	F	W1-10bR	36	36			9.00								8′ 2		11′-0" X								INSTALL 405 FT ± SOUTH OF EXISTING SIGN AT MP 5.451	X		
		F	W13-1P	18	18			2.25																		INSTALL ON LEFT POST	X		
SB	5.093	F	VD-701	6	8		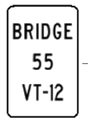						1		X															
		F	VD-701	6	10			0.42								4′ 1	5′-3" X												T-42
SB	5.070	G	VR-017	24	30		LLL 24,000 LBS						1		X														
		G	VD-700	6	8		MILE MARKER 0120 / 0903 / 0508						1																	
		G	VR-017	24	30			5.00								4′ 1	9′-8" X									INSTALL NEW SIGN AT SAME LOCATION ON BAKER POND RD			E-141
		G		18	12		THIS IS NOT AN ACCESS TO THE WATER					1														INSTALL ON LLL POST			
SB	5.066	H	R1-1	30	30		STOP						1		X														
		G		18	12		THIS IS NOT AN ACCESS TO THE WATER				1		1														SALVAGE TO NEW LLL POST AT MP 5.070			
		H	R1-1	30	30			6.25								4′ 1	10′-0" X										X		
		G	VD-700	6	10			0.42																		INSTALL BACK TO BACK ON STOP SIGN POST			T-44
SB	5.065	EF	D3-1	60	12			5.00								8′ 2	8′-6" 9′-2" X									INSTALL INDEPENDENTLY ON TWO POSTS ON STOP SIGN SIDE OF THE INTERSECTION		10	
SIGN SUMMARY SHEET							SHEET TOTALS	28.34	0.00	0	1	1	7	0	0	7	94′-1" ~~100.0~~			0	0.0	0.0	0.0	0.0				
								SF	SF	EA	EA	EA	EA	EA	EA	EA	FT			EA	LB	LB	LB	LB				
VERMONT AGENCY OF TRANSPORTATION							TOWN DIRECTIONAL TOTALS	232.3	0.0	4	1	1	44	0	0	43	615.0			0	0.0							

PROJECT NAME: **RANDOLPH-BERLIN**
PROJECT NUMBER: **STPG SIGN(52)**

FILE NAME: **z13c626tssbrookfield SB** PLOT DATE: **5/12/2015**
PROJECT MANAGER: **C. BEAN** DRAWN BY: **S. GOODWIN**
DESIGNED BY: **S. GOODWIN** CHECKED **D. MUNRO**
BROOKFIELD VT-12 SOUTHBOUND 1 SHEET **39** OF **105**