DIRECTION	MILEPOINT	LOCATION CODE (SHEET 3)	SIGN CODE	WIDTH (IN)	HEIGHT (IN)	SHEETING REMARKS	SIGN LEGEND	NEW SIGNS "A"	NEW SIGNS "B"	EXISTING SIGNS RETAIN	EXISTING SIGNS SALVAGE FROM	EXISTING SIGNS SALVAGE TO	EXISTING SIGNS REMOVE	EXIST POST RETAIN	EXIST POST REMOVE	NUMBER OF NEW POSTS	SQUARE STEEL (IN) 1.75 (LB / FT) 1.88	SQUARE STEEL (IN) 2.00 (LB / FT) 2.42	SQUARE STEEL (IN) 2.50 (LB / FT) 3.35	TUBULAR STEEL Ø (IN) FOUNDATION	TUBULAR STEEL Ø (IN) 3.00 (LB / FT) 7.60	TUBULAR STEEL Ø (IN) 3.50 (LB / FT) 9.00	TUBULAR STEEL Ø (IN) 4.00 (LB / FT) 10.80	TUBULAR STEEL Ø (IN) 5.00 (LB / FT) 14.60	SIGN FRAME REQUIRED	REMARKS	SIGN DETAIL LOCATION SHSM	SIGN DETAIL LOCATION PROJECT SHEET #	SIGN DETAIL LOCATION STANDARD SHEET #
SB BROOKFIELD VT 12							FY-FLUORESCENT YELLOW FYG-FLUORESCENT YELLOW GREEN									ANCHORS										"SHSM"-STANDARD HIGHWAY SIGNS AND MARKINGS BOOK			
SB	4.799	F	M2-1	21	15		JCT						1		X														
		F	VM1-5	24	24		VERMONT 65						1																
		F	VD-700	6	8		MILE MARKER 0120 / 0903 / 0482						1																
		F	M2-1	21	15			2.19								4′ 1		11′-4" X							JCT, **GREEN ON WHITE**			E-136B
		F	VM1-5	24	24			4.00																			VT ROUTE 65			E-136B
SB	4.749	F	VD-062BRN	72	16		RECREATIONAL AND CULTURAL INTEREST AREA GUIDE SIGN			1				X													ALLIS STATE PARK 1			
SB	4.713	F	D1-1a	72	10		^UP EAST BRAINTREE 5						1		X														
		F	D1-1a	72	10		^UP RANDOLPH 10						1																
		F	D1-1a	72	10		<--- BROOKFIELD 3						1																
		F	D1-1a	72	10		<--- FLOATING BRIDGE 3						1																
SB	4.709	F	VD1-1A	72	12		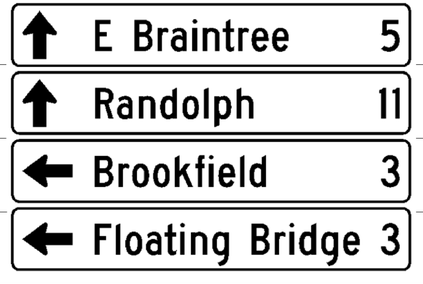	6.00								8′ 2		14′-8" 2′-10" X							INSTALL 20 FT ± SOUTH OF EXISTING SIGNS AT MP 4.713		8	
		F	VD1-1A	72	12			6.00																					8
		F	VD1-1A	72	12			6.00																					8
		F	VD1-1A	72	12			6.00																					8
SIGN SUMMARY SHEET							SHEET TOTALS	30.19	0.00	1	0	0	7	0	0	3		~~50′-10"~~ ~~45.0~~		0	0.0	0.0	0.0	0.0					
								SF	SF	EA	EA	EA	EA	EA	EA	EA		FT		EA	LB	LB	LB	LB					
VERMONT AGENCY OF TRANSPORTATION							TOWN DIRECTIONAL TOTALS	232.3	0.0	4	1	1	44	0	0	43		615.0		0	0.0								

PROJECT NAME: **RANDOLPH-BERLIN**
PROJECT NUMBER: **STPG SIGN(52)**
FILE NAME: **z13c626tssbrookfield SB**
PROJECT MANAGER: **C. BEAN**
DESIGNED BY: **S. GOODWIN**
BROOKFIELD VT-12 SOUTHBOUND 2
PLOT DATE: **5/12/2015**
DRAWN BY: **S. GOODWIN**
CHECKED **D. MUNRO**
SHEET **40** OF **105**