DIRECTION	MILEPOINT	LOCATION CODE (SHEET 3)	SIGN CODE	WIDTH (IN)	HEIGHT (IN)	SHEETING REMARKS	SIGN LEGEND	NEW SIGNS "A"	NEW SIGNS "B"	EXISTING SIGNS RETAIN	EXISTING SIGNS SALVAGE FROM	EXISTING SIGNS SALVAGE TO	EXISTING SIGNS REMOVE	EXIST POST RETAIN	EXIST POST REMOVE	NUMBER OF NEW POSTS	SQUARE STEEL (IN) 1.75 (LB / FT) 1.88	SQUARE STEEL (IN) 2.00 (LB / FT) 2.42	SQUARE STEEL (IN) 2.50 (LB / FT) 3.35	TUBULAR STEEL Ø (IN) FOUNDATION	TUBULAR STEEL Ø (IN) 3.00 (LB / FT) 7.60	TUBULAR STEEL Ø (IN) 3.50 (LB / FT) 9.00	TUBULAR STEEL Ø (IN) 4.00 (LB / FT) 10.80	TUBULAR STEEL Ø (IN) 5.00 (LB / FT) 14.60	SIGN FRAME REQUIRED	REMARKS	SIGN DETAIL LOCATION SHSM	SIGN DETAIL LOCATION PROJECT SHEET #	SIGN DETAIL LOCATION STANDARD SHEET #
SB BROOKFIELD VT 12							FY-FLUORESCENT YELLOW FYG-FLUORESCENT YELLOW GREEN									ANCHORS										"SHSM"-STANDARD HIGHWAY SIGNS AND MARKINGS BOOK			
SB	4.665	F	M3-2	24	12		EAST						1		X														
		F	VM1-5	24	24		VERMONT 65						1																
		F	M6-1	21	15		<--- LEFT						1																
		F	M3-3	24	12		SOUTH						1																
		F	VM1-5	24	24		VERMONT 12						1																
		F	M6-3	21	15		^UP ARROW						1																
		F	M3-2	24	12			2.00								8′ 2	13′-2" 12′-1" X								2A	EAST, **GREEN ON WHITE;**			E-136B
		F	VM1-5	24	24			4.00																		VT ROUTE 65			E-136B
		F	M6-1	21	15			2.19																		LEFT ARROW, **GREEN ON WHITE**			E-136B
		F	M3-3	24	12			2.00																		SOUTH, **GREEN ON WHITE**			E-136B
		F	VM1-5	24	24			4.00																		VT ROUTE 12			E-136B
		F	M6-3	21	15			2.19																		UP ARROW, **GREEN ON WHITE**			E-136B
SB	4.634	G	W1-7	48	24		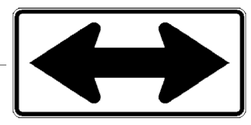						1		X														
		G	W1-7	48	24			8.00								8′ 2	10′-2" 10′-1" X										X		
SB	4.633	G	M3-3	24	12		SOUTH (CONT. ON NEXT SHEET)						1		X														
							SHEET TOTALS	24.38	0.00	0	0	0	8	0	0	4	6′-6" ~~60.0~~			0	0.0	0.0	0.0	0.0					
								SF	SF	EA	EA	EA	EA	EA	EA	EA	FT			EA	LB	LB	LB	LB					
							TOWN DIRECTIONAL TOTALS	232.3	0.0	4	1	1	44	0	0	43	615.0			0	0.0								

SIGN SUMMARY SHEET

VERMONT AGENCY OF TRANSPORTATION

PROJECT NAME: **RANDOLPH-BERLIN**
PROJECT NUMBER: **STPG SIGN(52)**

FILE NAME: **z13c626tssbrookfield SB** PLOT DATE: **5/12/2015**
PROJECT MANAGER: **C. BEAN** DRAWN BY: **S. GOODWIN**
DESIGNED BY: **S. GOODWIN** CHECKED **D. MUNRO**
BROOKFIELD VT-12 SOUTHBOUND 3 SHEET **41** OF **105**