DIRECTION	MILEPOINT	LOCATION CODE (SHEET 3)	SIGN CODE	WIDTH (IN)	HEIGHT (IN)	SHEETING REMARKS	SIGN LEGEND	NEW SIGNS "A"	NEW SIGNS "B"	EXISTING SIGNS RETAIN	EXISTING SIGNS SALVAGE FROM	EXISTING SIGNS SALVAGE TO	EXISTING SIGNS REMOVE	EXIST POST RETAIN	EXIST POST REMOVE	NUMBER OF NEW POSTS	SQUARE STEEL (IN) 1.75 (LB / FT) 1.88	SQUARE STEEL (IN) 2.00 (LB / FT) 2.42	SQUARE STEEL (IN) 2.50 (LB / FT) 3.35	TUBULAR STEEL Ø (IN) FOUNDATION	TUBULAR STEEL Ø (IN) 3.00 (LB / FT) 7.60	TUBULAR STEEL Ø (IN) 3.50 (LB / FT) 9.00	TUBULAR STEEL Ø (IN) 4.00 (LB / FT) 10.80	TUBULAR STEEL Ø (IN) 5.00 (LB / FT) 14.60	SIGN FRAME REQUIRED	REMARKS	SIGN DETAIL LOCATION SHSM	SIGN DETAIL LOCATION PROJECT SHEET #	SIGN DETAIL LOCATION STANDARD SHEET #
SB BROOKFIELD VT 12							FY-FLUORESCENT YELLOW FYG-FLUORESCENT YELLOW GREEN									ANCHORS										"SHSM"-STANDARD HIGHWAY SIGNS AND MARKINGS BOOK			
		G	VM1-5	24	24		VERMONT 12 (CONT.)						1																
		G	M6-1	21	15		<--- LEFT						1																
		G	M3-1	24	12		NORTH						1																
		G	VM1-5	24	24		VERMONT 12						1																
		G	M6-1	21	15		RIGHT --->						1																
		G	M3-3	24	12			2.00								8′ 2		12′-2" 12′-3" X							2A	SOUTH, **GREEN ON WHITE;**			E-136B
		G	VM1-5	24	24			4.00																		VT ROUTE 12			E-136B
		G	M6-1	21	15			2.19																		LEFT ARROW, **GREEN ON WHITE**			E-136B
		G	M3-1	24	12			2.00																		NORTH, **GREEN ON WHITE**			E-136B
		G	VM1-5	24	24			4.00																		VT ROUTE 12			E-136B
		G	M6-1	21	15			2.19																		RIGHT ARROW, **GREEN ON WHITE**			E-136B
SB	4.610	F	M3-3	24	12			2.00								4′ 1		10′-10" X								SOUTH, **GREEN ON WHITE;** INSTALL 120 FT ± SOUTH OF EXISTING SIGN AT MP 4.633			E-136B
		F	VM1-5	24	24			4.00																		VT ROUTE 12			E-136B
SB	4.557	F	VD2-1	72	12		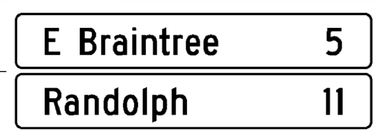	6.00								8′ 2		8′-8" 8′-6" X								INSTALL 280 FT ± SOUTH OF NEW SIGN AT MP 4.610		8	
		F	VD2-1	72	12			6.00																				8	
SIGN SUMMARY SHEET							SHEET TOTALS	34.38	0.00	0	0	0	5	0	0	5		72′-5" ~~75.0~~		0	0.0	0.0	0.0	0.0					
								SF	SF	EA	EA	EA	EA	EA	EA	EA		FT		EA	LB	LB	LB	LB					
VERMONT AGENCY OF TRANSPORTATION							TOWN DIRECTIONAL TOTALS	232.3	0.0	4	1	1	44	0	0	43		615.0		0	0.0								

PROJECT NAME: **RANDOLPH-BERLIN**
PROJECT NUMBER: **STPG SIGN(52)**

FILE NAME: **z13c626tss brookfield SB** PLOT DATE: **5/12/2015**
PROJECT MANAGER: **C. BEAN** DRAWN BY: **S. GOODWIN**
DESIGNED BY: **S. GOODWIN** CHECKED **D. MUNRO**
BROOKFIELD VT-12 SOUTHBOUND 4 SHEET **42** OF **105**