DIRECTION	MILEPOINT	LOCATION CODE (SHEET 3)	SIGN CODE	WIDTH (IN)	HEIGHT (IN)	SHEETING REMARKS	SIGN LEGEND	NEW SIGNS "A"	NEW SIGNS "B"	EXISTING SIGNS RETAIN	EXISTING SIGNS SALVAGE FROM	EXISTING SIGNS SALVAGE TO	EXISTING SIGNS REMOVE	EXIST POST RETAIN	EXIST POST REMOVE	NUMBER OF NEW POSTS	SQUARE STEEL (IN) 1.75 (LB/FT) 1.88	SQUARE STEEL (IN) 2.00 (LB/FT) 2.42	SQUARE STEEL (IN) 2.50 (LB/FT) 3.35	TUBULAR STEEL Ø (IN) FOUNDATION	TUBULAR STEEL Ø (IN) 3.00 (LB/FT) 7.60	TUBULAR STEEL Ø (IN) 3.50 (LB/FT) 9.00	TUBULAR STEEL Ø (IN) 4.00 (LB/FT) 10.80	TUBULAR STEEL Ø (IN) 5.00 (LB/FT) 14.60	SIGN FRAME REQUIRED	REMARKS	SIGN DETAIL LOCATION SHSM	SIGN DETAIL LOCATION PROJECT SHEET #	SIGN DETAIL LOCATION STANDARD SHEET #
SB BROOKFIELD VT 12							FY-FLUORESCENT YELLOW FYG-FLUORESCENT YELLOW GREEN									ANCHORS										"SHSM"-STANDARD HIGHWAY SIGNS AND MARKINGS BOOK			
SB	3.357	F	W1-2L	30	30	**FY**		6.25								4′ 1	10′-2" X									TYPE IX FLUORESCENT YELLOW SHEETING	X		
		F	W13-1P	18	18	**FY**		2.25																		TYPE IX FLUORESCENT YELLOW SHEETING	X		
SB	3.090	F	W1-2L	30	30	**FY**		6.25								4′ 1	8′-5" X									TYPE IX FLUORESCENT YELLOW SHEETING	X		
		F	W13-1P	18	18	**FY**		2.25																		TYPE IX FLUORESCENT YELLOW SHEETING	X		
SB	2.860 - 2.159	F	N/A	6	8		INSTALL (38) NEW DELINEATOR POSTS																			INSTALL (76) TYPE II 6"x8" WHITE DELINEATORS BACK TO BACK ON 38 NEW POSTS; INSTALL THE FIRST POST 50 FT ± AFTER GRAVEL PULLOFF, THEN EVERY 100 FT ±		5	
SB	2.787	F	W1-4R	30	30	**FY**		6.25								4′ 1	11′-11" X									INSTALL 125 FT ± SOUTH OF PULLOFF AT MP 2.811. TYPE IX FLUORESCENT YELLOW SHEETING.	X		
		F	W13-1P	18	18	**FY**		2.25																		TYPE IX FLUORESCENT YELLOW SHEETING	X		
SB	2.125	F	VD-701	6	8		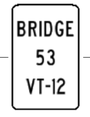						1		X														
		F	VD-701	6	10			0.42								4′ 1	5′-4" X											T-42
SB	1.772	F	VD-701	6	8		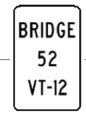						1		X														
		F	VD-701	6	10			0.42								4′ 1	4′-9" X											T-42
SB	1.610 - 1.421	F	N/A	6	8		INSTALL (11) NEW DELINEATOR POSTS																			INSTALL (22) TYPE II 6"x8" WHITE DELINEATORS BACK TO BACK ON 11 NEW POSTS; INSTALL THE FIRST POST AT MP 1.610 JUST SOUTH OF DRIVEWAY, THEN EVERY 100 FT ±		5	
SB	1.200	F	W1-4R	30	30	**FY**		6.25								4′ 1	11′-2" X									TYPE IX FLUORESCENT YELLOW SHEETING	X		
							SHEET TOTALS	32.59 SF	0.00 SF	0 EA	0 EA	0 EA	2 EA	0 EA	0 EA	6 EA	75′-9" ~~80.0~~ FT		0 EA	0.0 LB	0.0 LB	0.0 LB	0.0 LB				
							TOWN DIRECTIONAL TOTALS	232.3	0.0	4	1	1	44	0	0	43	615.0		0	0.0							

SIGN SUMMARY SHEET

VERMONT AGENCY OF TRANSPORTATION

PROJECT NAME: **RANDOLPH-BERLIN**
PROJECT NUMBER: **STPG SIGN(52)**

FILE NAME: **z13c626tssbrookfield SB** PLOT DATE: **5/12/2015**
PROJECT MANAGER: **C. BEAN** DRAWN BY: **S. GOODWIN**
DESIGNED BY: **S. GOODWIN** CHECKED **D. MUNRO**
BROOKFIELD VT-12 SOUTHBOUND 6 SHEET **44** OF **105**