DIRECTION	MILEPOINT	LOCATION CODE (SHEET 3)	SIGN CODE	WIDTH (IN)	HEIGHT (IN)	SHEETING REMARKS	SIGN LEGEND	NEW SIGNS "A"	NEW SIGNS "B"	EXISTING SIGNS RETAIN	EXISTING SIGNS SALVAGE FROM	EXISTING SIGNS SALVAGE TO	EXISTING SIGNS REMOVE	EXIST POST RETAIN	EXIST POST REMOVE	NUMBER OF NEW POSTS	SQUARE STEEL (IN) 1.75 (LB / FT) 1.88	SQUARE STEEL (IN) 2.00 (LB / FT) 2.42	SQUARE STEEL (IN) 2.50 (LB / FT) 3.35	FOUNDATION	TUBULAR STEEL Ø (IN) 3.00 (LB / FT) 7.60	TUBULAR STEEL Ø (IN) 3.50 (LB / FT) 9.00	TUBULAR STEEL Ø (IN) 4.00 (LB / FT) 10.80	TUBULAR STEEL Ø (IN) 5.00 (LB / FT) 14.60	SIGN FRAME REQUIRED	REMARKS	SIGN DETAIL LOCATION SHSM	SIGN DETAIL LOCATION PROJECT SHEET #	SIGN DETAIL LOCATION STANDARD SHEET #
NB NORTHFIELD VT 12							FY-FLUORESCENT YELLOW FYG-FLUORESCENT YELLOW GREEN									ANCHORS										"SHSM"-STANDARD HIGHWAY SIGNS AND MARKINGS BOOK			
		D	R1-1	30	30		0120 1213 2770 0120 1213 0277 (CONT.)	0.42 0.42 6.25					1			4′ 1		9′-6" X							ADD NEW MM PLAQUE MM ERROR - REINSTALL	X		
NB	2.770	AB	D3-1	63	12			5.25								8′ 2		7′-2" 7′-6" X							INSTALL INDEPENDENTLY ON TWO POSTS ON STOP SIGN SIDE OF THE INTERSECTION		10	
NB	2.875	A	W3-5	36	36		REDUCE SL 30 AHEAD						1		X														
NB	2.878	C	VR-017	24	30								1		X											WINCH VIEW (TH-103)			
		C	VR-017	24	30			5.00								4′ 1		11′-3" X								INSTALL NEW SIGN AT SAME LOCATION ON WINCH VIEW			E-141
NB	2.887	AB	D-3	30	9		WINCH VIEW						1		X														
		D	R1-1	30	30								1																
		C	VD-700	6	8		MILE MARKER 0120 / 1213 / 0289						1															
		D	R1-1	30	30			6.25								4′ 1		9′-4" X									X		
		C	VD-700	6	10			0.42																		INSTALL BACK TO BACK ON STOP SIGN POST			T-44
NB	2.887	AB	D3-1	51	12		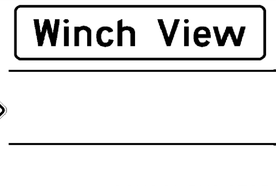	4.25								8′ 2 ~~1~~		7′-1" 7′-2" X							INSTALL INDEPENDENTLY ON TWO POSTS ON STOP SIGN SIDE OF THE INTERSECTION		10	
NB	2.934	A	W3-5	36	36			9.00								8′ 2		8′-6" 7′-4" X							INSTALL 50 FT ± SOUTH OF EXISTING SIGN AT MP 2.944	X		
NB	2.944	A	S3-1	30	30		SCHOOL BUS STOP AHEAD						1		X											SIGN NO LONGER WARRANTED			
NB	3.011	A	M2-1	21	15		JCT						1		X														
		A	VM1-5	24	24		VT ROUTE 12A (CONT. ON NEXT SHEET)						1																
SIGN SUMMARY SHEET							SHEET TOTALS	37.26 ~~36.42~~	0.00	0	0	0	9 ~~8~~	0	0	9 ~~7~~		110′-10" ~~105.0~~		0	0.0	0.0	0.0	0.0					
								SF	SF	EA	EA	EA	EA	EA	EA	EA		FT		EA	LB	LB	LB	LB					
VERMONT AGENCY OF TRANSPORTATION							TOWN DIRECTIONAL TOTALS	439.4	0.0	27	0	0	95	0	0	79		1160.0		0	0.0								

PROJECT NAME: RANDOLPH-BERLIN
PROJECT NUMBER: STPG SIGN(52)

FILE NAME: z13c626tssnorthfield NB
PROJECT MANAGER: C. BEAN
DESIGNED BY: S. GOODWIN
NORTHFIELD VT-12 NORTHBOUND 8

PLOT DATE: 5/12/2015
DRAWN BY: S. GOODWIN
CHECKED D. MUNRO
SHEET 60 OF 105