DIRECTION	MILEPOINT	LOCATION CODE (SHEET 3)	SIGN CODE	WIDTH (IN)	HEIGHT (IN)	SHEETING REMARKS	SIGN LEGEND	NEW SIGNS "A"	NEW SIGNS "B"	EXISTING SIGNS RETAIN	EXISTING SIGNS SALVAGE FROM	EXISTING SIGNS SALVAGE TO	EXISTING SIGNS REMOVE	EXIST POST RETAIN	EXIST POST REMOVE	NUMBER OF NEW POSTS	SQUARE STEEL (IN) 1.75 (LB / FT) 1.88	SQUARE STEEL (IN) 2.00 (LB / FT) 2.42	SQUARE STEEL (IN) 2.50 (LB / FT) 3.35	TUBULAR STEEL Ø (IN) FOUNDATION	TUBULAR STEEL Ø (IN) 3.00 (LB / FT) 7.60	TUBULAR STEEL Ø (IN) 3.50 (LB / FT) 9.00	TUBULAR STEEL Ø (IN) 4.00 (LB / FT) 10.80	TUBULAR STEEL Ø (IN) 5.00 (LB / FT) 14.60	SIGN FRAME REQUIRED	REMARKS	SIGN DETAIL LOCATION SHSM	SIGN DETAIL LOCATION PROJECT SHEET #	SIGN DETAIL LOCATION STANDARD SHEET #
NB NORTHFIELD VT 12							FY-FLUORESCENT YELLOW FYG-FLUORESCENT YELLOW GREEN									ANCHORS										"SHSM"-STANDARD HIGHWAY SIGNS AND MARKINGS BOOK			
NB	5.746	A	W11-2	30	30	**FYG**		6.25								4′ 1	10′-1" X									INSTALL 25 FT ± SOUTH OF EXISTING SIGN AT MP 5.751	X		
		A	W16-9p	24	12	**FYG**		2.00																			X		
NB	5.751	A	W11-2	30	30		PEDESTRIAN						1		X														
		A	W16-9p	24	10		AHEAD						1																
NB	5.787	C	VR-017	24	30		LLL 24,000 LBS						1		X												DAVIS AVE (TH-16)			
		C	R2-1	24	30		SPEED LIMIT 25						1																
		C		18	24		NEIGHBORHOOD WATCH SIGN						1											RETURN TO TOWN			
		C	VR-017	24	30			5.00								4′ 1	11′-10" X									INSTALL NEW SIGN AT SAME LOCATION ON DAVIS AVE			E-141
		C	R2-1	24	30			5.00																			X		
NB	5.791	AB	D-3	18	9		DAVIS AVE						1		X														
		AB	D3-1	42	12		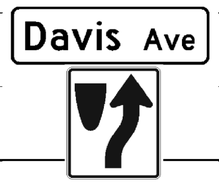	3.50								4′ 1	9′-8" X									INSTALL AT SAME LOCATION IN ISLAND ON ONE POST ABOVE KEEP RIGHT SIGN.		10	
		C	R4-7	24	30			5.00																		INSTALL SIGN PARALLEL TO VT 12 WITH SLIGHT ANGLE FACING TOWARD VT 12 SOUTHBOUND TRAFFIC			
NB	5.791	D	R1-1	30	30		STOP						1		X														
		D	R4-7	24	30		KEEP RIGHT MEDIAN SIGN						1																
		D	R1-1	30	30		(CONT. ON NEXT SHEET)	6.25								4′ 1	11′-9" X									INSTALL AT SAME LOCATION IN ISLAND FACING DAVIS AVE	X		
SIGN SUMMARY SHEET							SHEET TOTALS	33.00	0.00	0	0	0	8	0	0	4	~~59′-4"~~ 60.0			0	0.0	0.0	0.0	0.0					
								SF	SF	EA	EA	EA	EA	EA	EA	EA	FT			EA	LB	LB	LB	LB					
VERMONT AGENCY OF TRANSPORTATION							TOWN DIRECTIONAL TOTALS	439.4	0.0	27	0	0	95	0	0	79	1160.0			0	0.0								

PROJECT NAME: **RANDOLPH-BERLIN**
PROJECT NUMBER: **STPG SIGN(52)**

FILE NAME: **z13c626tssnorthfield NB** PLOT DATE: **5/12/2015**
PROJECT MANAGER: **C. BEAN** DRAWN BY: **S. GOODWIN**
DESIGNED BY: **S. GOODWIN** CHECKED **D. MUNRO**
NORTHFIELD VT-12 NORTHBOUND 11 SHEET **63** OF **105**