DIRECTION	MILEPOINT	LOCATION CODE (SHEET 3)	SIGN CODE	WIDTH (IN)	HEIGHT (IN)	SHEETING REMARKS	SIGN LEGEND	NEW SIGNS "A"	NEW SIGNS "B"	EXISTING SIGNS RETAIN	EXISTING SIGNS SALVAGE FROM	EXISTING SIGNS SALVAGE TO	EXISTING SIGNS REMOVE	EXIST POST RETAIN	EXIST POST REMOVE	NUMBER OF NEW POSTS	SQUARE STEEL (IN) 1.75 (LB/FT) 1.88	SQUARE STEEL (IN) 2.00 (LB/FT) 2.42	SQUARE STEEL (IN) 2.50 (LB/FT) 3.35	TUBULAR STEEL Ø (IN) FOUNDATION	TUBULAR STEEL Ø (IN) 3.00 (LB/FT) 7.60	TUBULAR STEEL Ø (IN) 3.50 (LB/FT) 9.00	TUBULAR STEEL Ø (IN) 4.00 (LB/FT) 10.80	TUBULAR STEEL Ø (IN) 5.00 (LB/FT) 14.60	SIGN FRAME REQUIRED	REMARKS	SIGN DETAIL LOCATION SHSM	SIGN DETAIL LOCATION PROJECT SHEET #	SIGN DETAIL LOCATION STANDARD SHEET #
NB BERLIN VT12							FY-FLUORESCENT YELLOW FYG-FLUORESCENT YELLOW GREEN									ANCHORS										"SHSM"-STANDARD HIGHWAY SIGNS AND MARKINGS BOOK			
NB	1.939	A	W11-2	30	30		PEDESTRIAN						1		X														
		A	W16-9p	24	10		AHEAD						1																
NB	1.945	A	W11-2	30	30	FYG		6.25								4′ 1		10′-11" X								INSTALL 115 FT ± NORTH OF EXISTING SIGN AT MP 1.923	X		
		A	W16-9p	24	12	FYG		2.00																			X		
NB	1.945	B	W1-8R	18	24		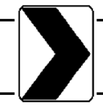	3.00								4′ 1		9′-7" X								INSTALL SIGN FACING SOUTHBOUND TRAFFIC	X		
NB	1.963	A	W1-8L	18	24		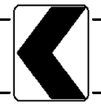	3.00								4′ 1		9′-8" X								INSTALL 95 FT ± NORTH OF PROPOSED SIGN AT MP 1.945	X		
NB	1.963	B	W1-8R	18	24		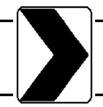	3.00								4′ 1		9′-10" X								INSTALL SIGN FACING SOUTHBOUND TRAFFIC	X		
NB	1.989	A	W10-1	30	30								1		X														
		A	W10-1	36	36			9.00								~~2~~ 4′ 1		9′-10" X								NOTE: NEW SIGN IS LARGER	X		
NB	1.989	C	VR-017	24	30								1		X												CROSSTOWN RD (TH-40)			
		C	R2-1	24	30								1																
		C	VR-017	24	30			5.00								4′ 1		11′-2" X								INSTALL NEW SIGNS AT SAME LOCATION ON CROSSTOWN RD			E-141
		C	R2-1	24	30			5.00																			X		
NB	1.989	AB	D-3	30	6		CROSSTOWN RD TH 40						1		X												CROSSTOWN RD (TH-40)			
NB	1.990	AB	D3-1	57	12			4.75								8′ 2		7′-9" 6′-6" X								INSTALL INDEPENDENTLY ON TWO POSTS CLOSER TO INTERSECTION ON LEGAL LOAD SIDE.		11	
SIGN SUMMARY SHEET							SHEET TOTALS	41.00	0.00	0	0	0	6	0	0	~~8~~ ~~9~~		~~107′-3"~~ ~~135.0~~		0	0.0	0.0	0.0	0.0					
								SF	SF	EA	EA	EA	EA	EA	EA	EA		FT		EA	LB	LB	LB	LB					
VERMONT AGENCY OF TRANSPORTATION							TOWN DIRECTIONAL TOTALS	399.8	0.0	8	3	3	83	0	0	96		1385.0		0		0.0							

PROJECT NAME: **RANDOLPH-BERLIN**
PROJECT NUMBER: **STPG SIGN(52)**

FILE NAME: **z13c626tssberlin NB**
PROJECT MANAGER: **C. BEAN**
DESIGNED BY: **S. GOODWIN**
BERLIN VT-12 NORTHBOUND 7

PLOT DATE: **5/12/2015**
DRAWN BY: **S. GOODWIN**
CHECKED **D. MUNRO**
SHEET **86** OF **105**