DIRECTION	MILEPOINT	LOCATION CODE (SHEET 3)	SIGN CODE	WIDTH (IN)	HEIGHT (IN)	SHEETING REMARKS	SIGN LEGEND	NEW SIGNS "A"	NEW SIGNS "B"	EXISTING SIGNS RETAIN	EXISTING SIGNS SALVAGE FROM	EXISTING SIGNS SALVAGE TO	EXISTING SIGNS REMOVE	EXIST POST RETAIN	EXIST POST REMOVE	NUMBER OF NEW POSTS	SQUARE STEEL (IN) 1.75 (LB/FT) 1.88	SQUARE STEEL (IN) 2.00 (LB/FT) 2.42	SQUARE STEEL (IN) 2.50 (LB/FT) 3.35	TUBULAR STEEL Ø (IN) FOUNDATION	TUBULAR STEEL Ø (IN) 3.00 (LB/FT) 7.60	TUBULAR STEEL Ø (IN) 3.50 (LB/FT) 9.00	TUBULAR STEEL Ø (IN) 4.00 (LB/FT) 10.80	TUBULAR STEEL Ø (IN) 5.00 (LB/FT) 14.60	SIGN FRAME REQUIRED	REMARKS	SIGN DETAIL LOCATION SHSM	SIGN DETAIL LOCATION PROJECT SHEET #	SIGN DETAIL LOCATION STANDARD SHEET #
NB BERLIN VT12							FY-FLUORESCENT YELLOW FYG-FLUORESCENT YELLOW GREEN									ANCHORS										"SHSM"-STANDARD HIGHWAY SIGNS AND MARKINGS BOOK			
NB	2.003	D	R1-1	30	30		STOP						1		X														
		C	VD-700	6	8		MILE MARKER 0120 / 1203 / 0201						1																
		D	R1-1	30	30			6.25								4′ 1	10′-0" X								X		
		C	VD-700	6	10			0.42																	INSTALL BACK TO BACK ON STOP SIGN POST			T-44
NB	2.014	A	OM3-R	12	36								1		X														
		A	OM3-R	12	36			3.00								4′ 1	6′-10" X										INSTALL AT EXISTING LOCATION BETWEEN GUARDRAIL AND SIDEWALK. INSTALL AT 7 FT VERTICAL CLEARANCE.	X		
NB	2.014	A	VD-701	6	8		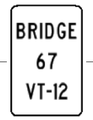						1		X															
		A	VD-701	6	10			0.42								4′ 1	4′-10" X												T-42
NB	2.042	B	OM3-L	12	36								1		X												SIGN FACING SOUTHBOUND TRAFFIC			
		B	OM3-L	12	36			3.00								4′ 1	6′-10" X										INSTALL AT EXISTING LOCATION BETWEEN GUARDRAIL AND SIDEWALK. INSTALL AT 7 FT VERTICAL CLEARANCE.	X		
NB	2.053	A	R2-1	24	30			5.00								4′ 1	9′-8" X										INSTALL 60 FT ± NORTH OF EXISTING SIGN AT MP 2.042			
NB	2.110	A	R15-1	48	48		RAIL ROAD CROSSING CROSS BUCK			1				X															
NB	2.147	A	W1-10d	30	30		MODIFIED REVERSE CURVE						1		X														
NB	2.216	A	W1-10R	36	36			9.00								8′ 2	9′-9" 9′-11" X										INSTALL 365 FT ± NORTH OF EXISTING SIGN AT MP 2.147	X		
		A	W16-8p	27	8			1.50																			INSTALL ON LEFT POST		7	
SIGN SUMMARY SHEET							SHEET TOTALS	28.59	0.00	1	0	0	6	0	0	7	85′-10" ~~100.0~~			0	0.0	0.0	0.0	0.0					
								SF	SF	EA	EA	EA	EA	EA	EA	EA	FT			EA	LB	LB	LB	LB					
VERMONT AGENCY OF TRANSPORTATION							TOWN DIRECTIONAL TOTALS	399.8	0.0	8	3	3	83	0	0	96	1385.0			0	0.0								

PROJECT NAME: **RANDOLPH-BERLIN**
PROJECT NUMBER: **STPG SIGN(52)**

FILE NAME: **z13c626tssberlin NB**
PROJECT MANAGER: **C. BEAN**
DESIGNED BY: **S. GOODWIN**
BERLIN VT-12 NORTHBOUND 8

PLOT DATE: **5/12/2015**
DRAWN BY: **S. GOODWIN**
CHECKED **D. MUNRO**
SHEET **87** OF **105**