DIRECTION	MILEPOINT	LOCATION CODE (SHEET 3)	SIGN CODE	WIDTH (IN)	HEIGHT (IN)	SHEETING REMARKS	SIGN LEGEND	NEW SIGNS "A"	NEW SIGNS "B"	EXISTING SIGNS RETAIN	EXISTING SIGNS SALVAGE FROM	EXISTING SIGNS SALVAGE TO	EXISTING SIGNS REMOVE	EXIST POST RETAIN	EXIST POST REMOVE	NUMBER OF NEW POSTS	SQUARE STEEL (IN) 1.75 (LB / FT) 1.88	SQUARE STEEL (IN) 2.00 (LB / FT) 2.42	SQUARE STEEL (IN) 2.50 (LB / FT) 3.35	TUBULAR STEEL Ø (IN) FOUNDATION	TUBULAR STEEL Ø (IN) 3.00 (LB / FT) 7.60	TUBULAR STEEL Ø (IN) 3.50 (LB / FT) 9.00	TUBULAR STEEL Ø (IN) 4.00 (LB / FT) 10.80	TUBULAR STEEL Ø (IN) 5.00 (LB / FT) 14.60	SIGN FRAME REQUIRED	REMARKS	SIGN DETAIL LOCATION SHSM	SIGN DETAIL LOCATION PROJECT SHEET #	SIGN DETAIL LOCATION STANDARD SHEET #
SB BERLIN VT 12							FY-FLUORESCENT YELLOW FYG-FLUORESCENT YELLOW GREEN									ANCHORS										"SHSM"-STANDARD HIGHWAY SIGNS AND MARKINGS BOOK			
SB	2.116	F	R15-1	48	48		RAIL ROAD CROSSING CROSS BUCK			1				X														
SB	2.049	F	R2-1	24	30								1		X														
		F	R2-1	24	30			5.00								4′ 1		9′-4" X									X		
SB	2.042	F	VD-701	6	8		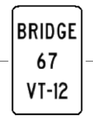						1		X														
		F	VD-701	6	10			0.42								4′ 1	4′-9" X												T-42
SB	2.042	F	OM3-R	12	36								1		X														
		F	OM3-R	12	36			3.00								4′ 1		6′-10" X									INSTALL AT 7 FT VERTICAL CLEARANCE	X		
SB	2.014	E	OM3-L	12	36								1		X												SIGN FACING NORTHBOUND TRAFFIC			
		E	OM3-L	12	36			3.00								4′ 1		6′-9" X									INSTALL AT 7 FT VERTICAL CLEARANCE	X		
SB	1.994	G	R2-1	24	30		SPEED LIMIT 25						1		X												AYERS RD (TH-54)			
		G	VR-017	24	30		LLL 24,000 LBS						1																
		G	VR-017	24	30			5.00									4′ 1		11′-11" X									INSTALL NEW SIGNS AT SAME LOCATION ON AYERS RD			E-141
		G	R2-1	24	30			5.00																				X		
SB	1.992	H	R1-1	30	30		STOP						1		X														
		G	VD-700	6	8		MILE MARKER 0120 / 1203 / 0201 (CONT. ON NEXT SHEET)				I		1														SEE MILE PLAQUE ON CROSSTOWN RD STOP SIGN			
SIGN SUMMARY SHEET							SHEET TOTALS	21.42	0.00	1	~~0~~ I	0	8	0	0	5		~~70.0~~ 59′-7"		0	0.0	0.0	0.0	0.0					
								SF	SF	EA	EA	EA	EA	EA	EA	EA		FT		EA	LB	LB	LB	LB					
VERMONT AGENCY OF TRANSPORTATION							TOWN DIRECTIONAL TOTALS	303.4	0.0	15	3	3	80	0	0	70		990.0		0		0.0							

PROJECT NAME: **RANDOLPH-BERLIN**
PROJECT NUMBER: **STPG SIGN(52)**

FILE NAME: **z13c626tssberlin SB**
PROJECT MANAGER: **C. BEAN**
DESIGNED BY: **S. GOODWIN**
BERLIN VT-12 SOUTHBOUND 8

PLOT DATE: **5/12/2015**
DRAWN BY: **S. GOODWIN**
CHECKED **D. MUNRO**
SHEET **100** OF **105**