DIRECTION	MILEPOINT	LOCATION CODE (SHEET 3)	SIGN CODE	WIDTH (IN)	HEIGHT (IN)	SHEETING REMARKS	SIGN LEGEND	NEW SIGNS "A"	NEW SIGNS "B"	EXISTING SIGNS RETAIN	EXISTING SIGNS SALVAGE FROM	EXISTING SIGNS SALVAGE TO	EXISTING SIGNS REMOVE	EXIST POST RETAIN	EXIST POST REMOVE	NUMBER OF NEW POSTS	SQUARE STEEL (IN) 1.75 (LB / FT) 1.88	SQUARE STEEL (IN) 2.00 (LB / FT) 2.42	SQUARE STEEL (IN) 2.50 (LB / FT) 3.35	TUBULAR STEEL Ø (IN) FOUNDATION	TUBULAR STEEL Ø (IN) 3.00 (LB / FT) 7.60	TUBULAR STEEL Ø (IN) 3.50 (LB / FT) 9.00	TUBULAR STEEL Ø (IN) 4.00 (LB / FT) 10.80	TUBULAR STEEL Ø (IN) 5.00 (LB / FT) 14.60	SIGN FRAME REQUIRED	REMARKS	SIGN DETAIL LOCATION SHSM	SIGN DETAIL LOCATION PROJECT SHEET #	SIGN DETAIL LOCATION STANDARD SHEET #
WB NEW HAVEN VT 17							FY-FLUORESCENT YELLOW FYG-FLUORESCENT YELLOW GREEN																		"SHSM"-STANDARD HIGHWAY SIGNS AND MARKINGS BOOK			
		F	D1-1a	72	20		(CONT.) BRIDGE TO NY STATE 16 --->						1															
WB	3.534	F	VD1-1A	72	12			6.00								2				2	180.50 ~~182.4~~				INSTALL 80 FT ± WEST OF EXISTING SIGN AT MP 3.549		8	
		F	VD1-1A	72	12			6.00																			8	
		F	VD1-1A	72	12			6.00																			8	
		F	VD1-1A	72	12		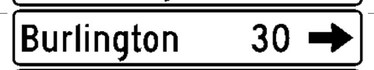	6.00																			8	
		F	VD1-1A	72	12		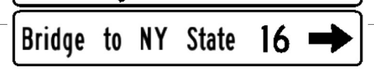	6.00																			8	
WB	3.498	F	M3-3	24	12		SOUTH						1		X													
		F	M1-4	24	24		US 7						1															
		F	M6-1	21	15		<--- LEFT						1															
		F	M3-1	24	12		NORTH						1															
		F	M1-4	24	24		US 7						1															
		F	M6-1	21	15		RIGHT --->						1															
		F	M3-4	24	12		WEST						1															
		F	VM1-5	24	24		VERMONT 17						1															
		F	M5-1	21	15		RIGHT ---> (90 DEG) (CONT. ON NEXT SHEET)						1															
SIGN SUMMARY SHEET							SHEET TOTALS	30.00	0.00	0	0	0	10	0	0	2		0.0		2	180.50 ~~182.4~~	0.0	0.0	0.0				
								SF	SF	EA	EA	EA	EA	EA	EA	EA		FT		EA	LB	LB	LB	LB				
VERMONT AGENCY OF TRANSPORTATION							TOWN DIRECTIONAL TOTALS	254.3	0.0	4	3	3	57	0	0	38		535.0		2	182.4							

PROJECT NAME: **STATEWIDE-SOUTHWEST**
PROJECT NUMBER: **STPG SIGN(51)**

FILE NAME: **z13e624tssnewhaven WB**
PROJECT MANAGER: **C. BEAN**
DESIGNED BY: **S. GOODWIN**
NEW HAVEN VT-17 WESTBOUND 7

PLOT DATE: **4/28/2015**
DRAWN BY: **S. GOODWIN**
CHECKED BY: **D. MUNRO**
SHEET **27** OF **121**