DIRECTION	MILEPOINT	LOCATION CODE (SHEET 3)	SIGN CODE	WIDTH (IN)	HEIGHT (IN)	SHEETING REMARKS	SIGN LEGEND	NEW SIGNS "A"	NEW SIGNS "B"	EXISTING SIGNS RETAIN	EXISTING SIGNS SALVAGE FROM	EXISTING SIGNS SALVAGE TO	EXISTING SIGNS REMOVE	EXIST POST RETAIN	EXIST POST REMOVE	NUMBER OF NEW POSTS	SQUARE STEEL (IN) (LB / FT) 1.75 / 1.88	SQUARE STEEL (IN) (LB / FT) 2.00 / 2.42	SQUARE STEEL (IN) (LB / FT) 2.50 / 3.35	TUBULAR STEEL Ø (IN) FOUNDATION	TUBULAR STEEL Ø (IN) (LB / FT) 3.00 / 7.60	TUBULAR STEEL Ø (IN) (LB / FT) 3.50 / 9.00	TUBULAR STEEL Ø (IN) (LB / FT) 4.00 / 10.80	TUBULAR STEEL Ø (IN) (LB / FT) 5.00 / 14.60	SIGN FRAME REQUIRED	REMARKS	SIGN DETAIL LOCATION SHSM	SIGN DETAIL LOCATION PROJECT SHEET #	SIGN DETAIL LOCATION STANDARD SHEET #
WB STARKSBORO VT 17							FY-FLUORESCENT YELLOW FYG-FLUORESCENT YELLOW GREEN																			"SHSM"-STANDARD HIGHWAY SIGNS AND MARKINGS BOOK			
WB	5.349	F	W1-1L	30	30			6.25								1		15.50 X								~~INSTALL 280 FT ± EAST OF EXISTING SIGN AT MP 5.250~~	X		
		F	W13-1P	18	18			2.25			2	2						4.00								FINAL PUNCHLIST ITEM SIGNS WERE REMOVED AND RESET (PROPERTY OWNER REQUEST)	X		
WB	5.250	E	W1-6	48	24								1		X														
		E	W1-6	48	24			8.00								2		11.25 12.00 X									X		
WB	5.243	F	W1-6	48	24								1		X														
		F	W1-6	48	24			8.00								2		12.25 11.50 X									X		
WB	5.235	F	D1-1a	72	12		HANKSVILLE 2 --->						1	X															
		F	D1-1a	72	12		HUNTINGTON CTR 6 --->						1																
		F	VD1-1A	72	12		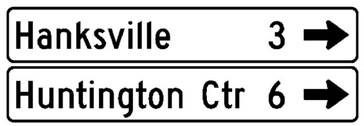	6.00																			10	
		F	VD1-1A	72	12			6.00																			10	
WB	5.196	G	VR-017	24	30								1		X												GORE RD (TH-4)			
		G	VR-017	24	30			5.00								1		13.75 X								INSTALL NEW SIGN AT SAME LOCATION ON GORE RD			E-141
WB	5.185	EF	D-3	18	6		GORE RD						1	X															
		H	R1-1	30	30		STOP			1																			
		G	VD-700	6	8		MILE MARKER 0170 / 0119 / 0521 (CONT. ON NEXT SHEET)						1																
							SHEET TOTALS	41.50	0.00	1	~~0~~ 2	~~0~~ 2	7	0	0	6		~~90.0~~ 80.25		0	0.0	0.0	0.0	0.0					
								SF	SF	EA	EA	EA	EA	EA	EA	EA		FT		EA	LB	LB	LB	LB					
							TOWN DIRECTIONAL TOTALS	169.8	0.0	5	2	2	38	0	0	36		495.0		0	0.0								

SIGN SUMMARY SHEET

VERMONT AGENCY OF TRANSPORTATION

PROJECT NAME: **STATEWIDE-SOUTHWEST**
PROJECT NUMBER: **STPG SIGN(51)**

FILE NAME: **z13e624tssstarksboro WB** PLOT DATE: **4/28/2015**
PROJECT MANAGER: **C. BEAN** DRAWN BY: **S. GOODWIN**
DESIGNED BY: **S. GOODWIN** CHECKED **D. MUNRO**
STARKSBORO VT-17 WESTBOUND 1 SHEET **48** OF **121**