DIRECTION	MILEPOINT	LOCATION CODE (SHEET 3)	SIGN CODE	WIDTH (IN)	HEIGHT (IN)	SHEETING REMARKS	SIGN LEGEND	NEW SIGNS "A"	NEW SIGNS "B"	EXISTING SIGNS RETAIN	EXISTING SIGNS SALVAGE FROM	EXISTING SIGNS SALVAGE TO	EXISTING SIGNS REMOVE	EXIST POST RETAIN	EXIST POST REMOVE	NUMBER OF NEW POSTS	SQUARE STEEL (IN) 1.75 (LB / FT) 1.88	SQUARE STEEL (IN) 2.00 (LB / FT) 2.42	SQUARE STEEL (IN) 2.50 (LB / FT) 3.35	FOUNDATION	TUBULAR STEEL Ø (IN) 3.00 (LB / FT) 7.60	TUBULAR STEEL Ø (IN) 3.50 (LB / FT) 9.00	TUBULAR STEEL Ø (IN) 4.00 (LB / FT) 10.80	TUBULAR STEEL Ø (IN) 5.00 (LB / FT) 14.60	SIGN FRAME REQUIRED	REMARKS	SIGN DETAIL LOCATION SHSM	SIGN DETAIL LOCATION PROJECT SHEET #	SIGN DETAIL LOCATION STANDARD SHEET #
WB BUELS GORE VT 17							FY-FLUORESCENT YELLOW FYG-FLUORESCENT YELLOW GREEN																			"SHSM"-STANDARD HIGHWAY SIGNS AND MARKINGS BOOK			
WB	2.626	F	W11-2	30	30								1		X														
		F	W16-9p	24	10								1																
		F	W11-2	30	30	FYG		6.25								1		14.50 X									X		
		F	W16-9p	24	12	FYG		2.00																		X		
WB	2.592	F	W1-1L	30	30	FY		6.25								1		15.00 X								INSTALL 200 FT ± WEST OF EXISTING SIGN AT MP 2.626	X		
		F	W13-1P	18	18	FY		2.25																		X		
WB	2.537	F	W11-2	30	30	FYG		6.25								1		16.00 X								INSTALL 50 FT ± EAST OF EXISTING SIGN AT MP 2.528	X		
		A	W16-4P	30	24	FYG		5.00																		X		
WB	2.528	F	W11-2	30	30		PEDESTRIAN SYMBOL						1		X														
		F	W16-7P	24	12		DIAGONAL DOWN ARROW						1																
WB	2.508	F	W1-6	48	24		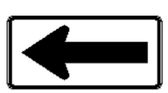						1	X															
		F	W1-6	48	24	FY		8.00																		X		
WB	2.503	E	W1-6	48	24		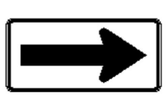						1	X															
		E	W1-6	48	24	FY		8.00																		X		
							SHEET TOTALS	44.00	0.00	0	0	0	6	0	0	3		~~45.0~~ 45.50		0	0.0	0.0	0.0	0.0					
								SF	SF	EA	EA	EA	EA	EA	EA	EA		FT		EA	LB	LB	LB	LB					
							TOWN DIRECTIONAL TOTALS	326.5	0.0	2	0	0	43	0	0	56		830.0		0		0.0							

SIGN SUMMARY SHEET

VERMONT AGENCY OF TRANSPORTATION

PROJECT NAME: STATEWIDE-SOUTHWEST
PROJECT NUMBER: STPG SIGN(51)

FILE NAME: z13e624tssbuelsgore WB
PROJECT MANAGER: C. BEAN
DESIGNED BY: S. GOODWIN
BUELS GORE VT-17 WESTBOUND 1

PLOT DATE: 4/28/2015
DRAWN BY: S. GOODWIN
CHECKED BY: D. MUNRO