DIRECTION	MILEPOINT	LOCATION CODE (SHEET 3)	SIGN CODE	WIDTH (IN)	HEIGHT (IN)	SHEETING REMARKS	SIGN LEGEND	NEW SIGNS "A"	NEW SIGNS "B"	EXISTING SIGNS RETAIN	EXISTING SIGNS SALVAGE FROM	EXISTING SIGNS SALVAGE TO	EXISTING SIGNS REMOVE	EXIST POST RETAIN	EXIST POST REMOVE	NUMBER OF NEW POSTS	SQUARE STEEL (IN) 1.75 (LB / FT) 1.88	SQUARE STEEL (IN) 2.00 (LB / FT) 2.42	SQUARE STEEL (IN) 2.50 (LB / FT) 3.35	TUBULAR STEEL Ø (IN) FOUNDATION	TUBULAR STEEL Ø (IN) 3.00 (LB / FT) 7.60	TUBULAR STEEL Ø (IN) 3.50 (LB / FT) 9.00	TUBULAR STEEL Ø (IN) 4.00 (LB / FT) 10.80	TUBULAR STEEL Ø (IN) 5.00 (LB / FT) 14.60	SIGN FRAME REQUIRED	REMARKS	SIGN DETAIL LOCATION SHSM	SIGN DETAIL LOCATION PROJECT SHEET #	SIGN DETAIL LOCATION STANDARD SHEET #
WB BUELS GORE VT 17							FY-FLUORESCENT YELLOW FYG-FLUORESCENT YELLOW GREEN																		"SHSM"-STANDARD HIGHWAY SIGNS AND MARKINGS BOOK			
		F	W13-1P	18	18		(CONT.) 25 M.P.H. (PLAQUE)						1															
		F	W1-11R	30	30	FY		6.25								1		15.50 X								X		
		F	W13-1P	24	24	FY		4.00																	X		
WB	1.637	F	W1-8	18	24		LEFT CHEVRON						1		X													
		E	W1-8	18	24		RIGHT CHEVRON						1															
		F	W1-8	18	24	FY	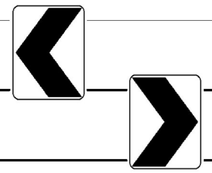	3.00								1		10.75 X								X		
WB	1.635	E	W1-8	18	24	FY		3.00								1		11.75 X								X		
WB	1.615	F	W1-8	18	24		LEFT CHEVRON						1		X													
		E	W1-8	18	24		RIGHT CHEVRON						1															
		F	W1-8	18	24	FY	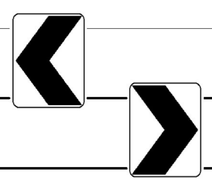	3.00								1		11.75 X								X		
WB	1.613	E	W1-8	18	24	FY		3.00								1		12.25 X								X		
WB	1.593	F	W1-1L	30	30		LEFT TURN						1		X													
		F	W13-1P	18	18		25 M.P.H. (PLAQUE)						1															
		F	W1-1L	30	30	FY		6.25								1		16.25 X								X		
		F	W13-1P	18	18	FY		2.25																	X		
SIGN SUMMARY SHEET							SHEET TOTALS	30.75	0.00	0	0	0	7	0	0	6		~~90.0~~ 78.25		0	0.0	0.0	0.0	0.0				
								SF	SF	EA	EA	EA	EA	EA	EA	EA		FT		EA	LB	LB	LB	LB				
VERMONT AGENCY OF TRANSPORTATION							TOWN DIRECTIONAL TOTALS	326.5	0.0	2	0	0	43	0	0	56		830.0		0		0.0						

PROJECT NAME: STATEWIDE-SOUTHWEST
PROJECT NUMBER: STPG SIGN(51)
FILE NAME: z13e624tss buelsgore WB
PROJECT MANAGER: C. BEAN
DESIGNED BY: S. GOODWIN
BUELS GORE VT-17 WESTBOUND 3
PLOT DATE: 4/28/2015
DRAWN BY: S. GOODWIN
CHECKED BY: D. MUNRO
SHEET 62 OF 121