DIRECTION	MILEPOINT	LOCATION CODE (SHEET 3)	SIGN CODE	WIDTH (IN)	HEIGHT (IN)	SHEETING REMARKS	SIGN LEGEND	NEW SIGNS "A"	NEW SIGNS "B"	EXISTING SIGNS RETAIN	EXISTING SIGNS SALVAGE FROM	EXISTING SIGNS SALVAGE TO	EXISTING SIGNS REMOVE	EXIST POST RETAIN	EXIST POST REMOVE	NUMBER OF NEW POSTS	SQUARE STEEL (IN) 1.75 (LB / FT) 1.88	SQUARE STEEL (IN) 2.00 (LB / FT) 2.42	SQUARE STEEL (IN) 2.50 (LB / FT) 3.35	TUBULAR STEEL Ø (IN) FOUNDATION	TUBULAR STEEL Ø (IN) 3.00 (LB / FT) 7.60	TUBULAR STEEL Ø (IN) 3.50 (LB / FT) 9.00	TUBULAR STEEL Ø (IN) 4.00 (LB / FT) 10.80	TUBULAR STEEL Ø (IN) 5.00 (LB / FT) 14.60	SIGN FRAME REQUIRED	REMARKS	SIGN DETAIL LOCATION SHSM	SIGN DETAIL LOCATION PROJECT SHEET #	SIGN DETAIL LOCATION STANDARD SHEET #
EB FAYSTON VT 17							FY-FLUORESCENT YELLOW FYG-FLUORESCENT YELLOW GREEN																			"SHSM"-STANDARD HIGHWAY SIGNS AND MARKINGS BOOK			
EB	3.800	A	VD-700	6	10		0170 1208 0380	0.42								1	8.75 X											T-44
EB	3.846	A	W1-8	24	18		LEFT CHEVRON						1		X													
EB	3.846	B	W1-8	24	18		RIGHT CHEVRON						1		X													
EB	3.847	A	W1-8	24	18		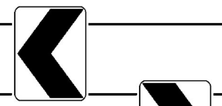	3.00								1		14.50 X								INSTALL 5 FT ± EAST OF EXISTING SIGNS AT MP 3.846	X		
EB	3.849	B	W1-8	24	18			3.00								1		14.75 X								INSTALL 15 FT ± EAST OF EXISTING SIGNS AT MP 3.846	X		
EB	3.855	A	W1-8	24	18		LEFT CHEVRON						1		X													
EB	3.855	B	W1-8	24	18		RIGHT CHEVRON						1		X													
EB	3.863	A	W1-8	24	18		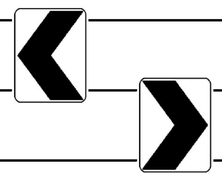	3.00								1		11.50 X								INSTALL 40 FT ± EAST OF EXISTING SIGNS AT MP 3.855	X		
EB	3.865	B	W1-8	24	18			3.00								1		11.75 X								INSTALL 50 FT ± EAST OF EXISTING SIGNS AT MP 3.855	X		
EB	3.867	A	W1-8	24	18		LEFT CHEVRON						1		X													
EB	3.878	A	W1-8	24	18		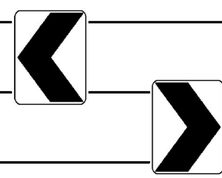	3.00								1		14.75 X								INSTALL 60 FT ± EAST OF EXISTING SIGN AT MP 3.867	X		
EB	3.880	B	W1-8	24	18			3.00								1		15.00 X								INSTALL 70 FT ± EAST OF EXISTING SIGN AT MP 3.867	X		
EB	3.979	A	VD-062B	72	16		OFFICIAL BUSINESS DIRECTIONAL SIGN			1				X														
EB	3.979	A	VD-062B	72	16		OFFICIAL BUSINESS DIRECTIONAL SIGN			1																		
							SHEET TOTALS	18.42	0.00	2	0	0	5	0	0	7	~~100.0~~ 91.00			0	0.0	0.0	0.0	0.0					
								SF	SF	EA	EA	EA	EA	EA	EA	EA	FT			EA	LB	LB	LB	LB					
							TOWN DIRECTIONAL TOTALS	478.8	0.0	16	0	0	79	0	0	83	1205.0			0	0.0								

SIGN SUMMARY SHEET

VERMONT AGENCY OF TRANSPORTATION

PROJECT NAME: **STATEWIDE-SOUTHWEST**
PROJECT NUMBER: **STPG SIGN(51)**

FILE NAME: **z13e624tss favston EB**
PROJECT MANAGER: **C. BEAN**
DESIGNED BY: **S. GOODWIN**
FAYSTON VT-17 EASTBOUND 9

PLOT DATE: **4/28/2015**
DRAWN BY: **S. GOODWIN**
CHECKED **D. MUNRO**
SHEET **76** OF **121**