DIRECTION	MILEPOINT	LOCATION CODE (SHEET 3)	SIGN CODE	WIDTH (IN)	HEIGHT (IN)	SHEETING REMARKS	SIGN LEGEND	NEW SIGNS "A"	NEW SIGNS "B"	EXISTING SIGNS RETAIN	EXISTING SIGNS SALVAGE FROM	EXISTING SIGNS SALVAGE TO	EXISTING SIGNS REMOVE	EXIST POST RETAIN	EXIST POST REMOVE	NUMBER OF NEW POSTS	SQUARE STEEL (IN) 1.75 (LB / FT) 1.88	SQUARE STEEL (IN) 2.00 (LB / FT) 2.42	SQUARE STEEL (IN) 2.50 (LB / FT) 3.35	TUBULAR STEEL Ø (IN) FOUNDATION	TUBULAR STEEL Ø (IN) 3.00 (LB / FT) 7.60	TUBULAR STEEL Ø (IN) 3.50 (LB / FT) 9.00	TUBULAR STEEL Ø (IN) 4.00 (LB / FT) 10.80	TUBULAR STEEL Ø (IN) 5.00 (LB / FT) 14.60	SIGN FRAME REQUIRED	REMARKS	SIGN DETAIL LOCATION SHSM	SIGN DETAIL LOCATION PROJECT SHEET #	SIGN DETAIL LOCATION STANDARD SHEET #
WB FAYSTON VT 17							FY-FLUORESCENT YELLOW FYG-FLUORESCENT YELLOW GREEN																			"SHSM"-STANDARD HIGHWAY SIGNS AND MARKINGS BOOK			
WB	2.308	E	W1-8	18	24	FY		3.00								1		11.25 X									X		
WB	2.295	F	W1-8	18	24		LEFT CHEVRON						1		X														
WB	2.295	E	W1-8	18	24		RIGHT CHEVRON						1		X														
WB	2.293	F	W1-8	18	24	FY	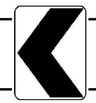	3.00								1		13.75 X									INSTALL 10 FT ± WEST OF EXISTING CHEVRONS AT MP 2.295	X		
WB	2.293	E	W1-8	18	24	FY		3.00								1		13.75 X									X		
WB	2.279	F	W1-8	18	24		LEFT CHEVRON						1		X														
WB	2.279	E	W1-8	18	24		RIGHT CHEVRON						1		X														
WB	2.278	F	W1-8	18	24	FY		3.00								1		12.25 X									INSTALL 5 FT ± WEST OF EXISTING CHEVRONS AT MP 2.279	X		
WB	2.278	E	W1-8	18	24	FY	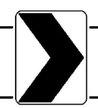	3.00								1		12.25 X									X		
WB	2.126	F	VD-701	6	8		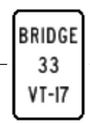						1		X														
		F	VD-701	6	10			0.42								1	7.50 X											T-42
WB	1.818	F	W1-3L	30	30	FY		6.25								1		17.00 X									INSTALL 50 FT ± WEST OF DRIVE	X		
		F	W13-1P	18	18	FY		2.25																			X		
WB	1.760	F	W1-8	18	24		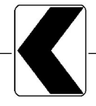						1	X															
		F	W1-8	18	24	FY		3.00																			X		
SIGN SUMMARY SHEET							SHEET TOTALS	26.92	0.00	0	0	0	6	0	0	7		~~100.0~~ 87.75		0	0.0	0.0	0.0	0.0					
								SF	SF	EA	EA	EA	EA	EA	EA	EA		FT		EA	LB	LB	LB	LB					
VERMONT AGENCY OF TRANSPORTATION							TOWN DIRECTIONAL TOTALS	386.6	0.0	19	0	0	60	0	0	57		835.0		0	0.0								

PROJECT NAME: **STATEWIDE-SOUTHWEST**
PROJECT NUMBER: **STPG SIGN(51)**

FILE NAME: **z13e624tss favston WB** PLOT DATE: **4/28/2015**
PROJECT MANAGER: **C. BEAN** DRAWN BY: **S. GOODWIN**
DESIGNED BY: **S. GOODWIN** CHECKED **D. MUNRO**
FAYSTON VT-17 WESTBOUND 7 SHEET **88** OF **121**