DIRECTION	MILEPOINT	LOCATION CODE (SHEET 3)	SIGN CODE	WIDTH (IN)	HEIGHT (IN)	SHEETING REMARKS	SIGN LEGEND	NEW SIGNS "A"	NEW SIGNS "B"	EXISTING SIGNS RETAIN	EXISTING SIGNS SALVAGE FROM	EXISTING SIGNS SALVAGE TO	EXISTING SIGNS REMOVE	EXIST POST RETAIN	EXIST POST REMOVE	NUMBER OF NEW POSTS	SQUARE STEEL (IN) 1.75 (LB/FT) 1.88	SQUARE STEEL (IN) 2.00 (LB/FT) 2.42	SQUARE STEEL (IN) 2.50 (LB/FT) 3.35	TUBULAR STEEL Ø (IN) FOUNDATION	TUBULAR STEEL Ø (IN) 3.00 (LB/FT) 7.60	TUBULAR STEEL Ø (IN) 3.50 (LB/FT) 9.00	TUBULAR STEEL Ø (IN) 4.00 (LB/FT) 10.80	TUBULAR STEEL Ø (IN) 5.00 (LB/FT) 14.60	SIGN FRAME REQUIRED	REMARKS	SIGN DETAIL LOCATION SHSM	SIGN DETAIL LOCATION PROJECT SHEET #	SIGN DETAIL LOCATION STANDARD SHEET #
WB FAYSTON VT 17							FY-FLUORESCENT YELLOW FYG-FLUORESCENT YELLOW GREEN																				"SHSM"-STANDARD HIGHWAY SIGNS AND MARKINGS BOOK			
WB	1.164	F	VW-629	48	48		NOT RECOMMENDED FOR WINTER TRAVEL BY TRUCKS, BUSSES OR RVS			1				X															
WB	1.149	F	M3-4	24	12		WEST			1				X															
		F	VM1-5	24	24		VERMONT 17			1																			
WB	1.215	F	W1-1L	30	30	FY		6.25								1		17.25 X								INSTALL 350 FT ± WEST OF EXISTING VT 17 SIGN AT MP 1.149	X		
		F	W13-1P	24	24	FY		4.00																				X		
WB	1.037	F	W1-6	48	24		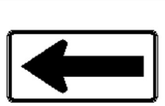			~~1~~			1	X																
		F	W1-6	48	24	FY		8.00																				X		
WB	1.032	E	W1-6	48	24		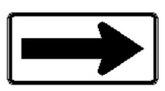			~~1~~			1	X																
		E	W1-6	48	24	FY		8.00																				X		
WB	0.676	F	W1-3L	30	30			6.25								1		17.00 X								INSTALL 625 FT ± EAST OF EXISTING ARROW BOARD AT MP 0.558	X		
		F	W13-1P	24	24			4.00																				X		
WB	0.650	F	W1-6	48	24	FY		8.00								2		12.00 12.50 X								INSTALL 485 FT ± EAST OF EXISTING ARROW BOARD AT MP 0.558	X		
WB	0.650	E	W1-6	48	24	FY	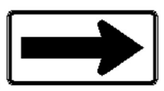	8.00								2		11.75 12.00 X									X		
WB	0.583	F	W1-11L	30	30	FY		6.25								1		15.50 X								INSTALL 130 FT ± EAST OF EXISTING ARROW BOARD AT MP 0.558	X		
		F	W13-1P	24	24	FY		4.00																				X		
							SHEET TOTALS	62.75	0.00	~~5~~ 3	0	0	~~0~~ 2	0	0	7		~~105.0~~ 98.00		0	0.0	0.0	0.0	0.0					
								SF	SF	EA	EA	EA	EA	EA	EA	EA		FT		EA	LB	LB	LB	LB					
							TOWN DIRECTIONAL TOTALS	386.6	0.0	19	0	0	60	0	0	57		835.0		0	0.0								

SIGN SUMMARY SHEET

VERMONT AGENCY OF TRANSPORTATION

PROJECT NAME: **STATEWIDE-SOUTHWEST**
PROJECT NUMBER: **STPG SIGN(51)**

FILE NAME: **z13e624tss favston WB** PLOT DATE: **4/28/2015**
PROJECT MANAGER: **C. BEAN** DRAWN BY: **S. GOODWIN**
DESIGNED BY: **S. GOODWIN** CHECKED **D. MUNRO**
FAYSTON VT-17 WESTBOUND 10 SHEET **91** OF **121**