DIRECTION	MILEPOINT	LOCATION CODE (SHEET 3)	SIGN CODE	WIDTH (IN)	HEIGHT (IN)	SHEETING REMARKS	SIGN LEGEND	NEW SIGNS "A"	NEW SIGNS "B"	EXISTING SIGNS RETAIN	EXISTING SIGNS SALVAGE FROM	EXISTING SIGNS SALVAGE TO	EXISTING SIGNS REMOVE	EXIST POST RETAIN	EXIST POST REMOVE	NUMBER OF NEW POSTS	SQUARE STEEL (IN) 1.75 (LB / FT) 1.88	SQUARE STEEL (IN) 2.00 (LB / FT) 2.42	SQUARE STEEL (IN) 2.50 (LB / FT) 3.35	TUBULAR STEEL Ø (IN) FOUNDATION	TUBULAR STEEL Ø (IN) 3.00 (LB / FT) 7.60	TUBULAR STEEL Ø (IN) 3.50 (LB / FT) 9.00	TUBULAR STEEL Ø (IN) 4.00 (LB / FT) 10.80	TUBULAR STEEL Ø (IN) 5.00 (LB / FT) 14.60	SIGN FRAME REQUIRED	REMARKS	SIGN DETAIL LOCATION SHSM	SIGN DETAIL LOCATION PROJECT SHEET #	SIGN DETAIL LOCATION STANDARD SHEET #
EB WAITSFIELD VT 17							FY-FLUORESCENT YELLOW FYG-FLUORESCENT YELLOW GREEN																			"SHSM"-STANDARD HIGHWAY SIGNS AND MARKINGS BOOK			
		A	VD1-1A	72	12		(CONT.)	6.00																				9	
		A	VD1-1A	72	12			6.00																				9	
		A	VD1-1A	72	12		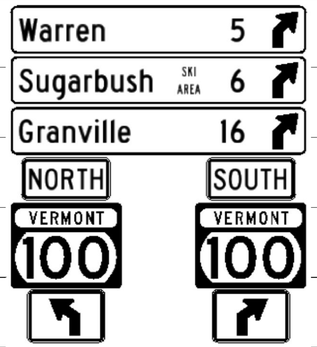	6.00																			9	
		A	M3-1	24	12							1															INSTALL ON LEFT POST			
		A	VM1-5	30	24							1															INSTALL ON LEFT POST			
		A	M5-2	21	15			2.19																			45 DEG LEFT HOOK ARROW, GREEN ON WHITE INSTALL ON LEFT POST	X		
		A	M3-3	24	12							1															INSTALL ON RIGHT POST			
		A	VM1-5	30	24							1															INSTALL ON RIGHT POST			
		A	M5-2	21	15			2.19																			45 DEG RIGHT HOOK ARROW, GREEN ON WHITE INSTALL ON RIGHT POST	X		
EB	0.173	J	OM1-1	18	18			2.25								1		9.00 X									INSTALL SIGN IN ISLAND FACING EASTBOUND TRAFFIC IN FRONT OF NEW ROUTE MARKER ASSEMBLY.	X		
EB	0.174	K	R1-1	30	30		STOP						1		X											SIGN FACES WESTBOUND TRAFFIC. INSTALLED IN ISLAND. MOVE TO MP 0.175.			
		J	OM1-1	18	18		OBJECT MARKER						1																	
		J	M3-1	24	12			2.00								2		15.25 15.25 X								2C	NORTH, GREEN ON WHITE INSTALL SIGN IN ISLAND FACING EASTBOUND TRAFFIC			E-136B
		J	VM1-5	30	24			5.00																			VT ROUTE 100			E-136B
		J	M6-2	21	15		(CONT. ON NEXT SHEET)	2.19																			45 DEG LEFT ARROW, GREEN ON WHITE			E-136B
SIGN SUMMARY SHEET							SHEET TOTALS	33.82	0.00	0	0	4	2	0	0	3		~~45.0~~ 39.50		0	0.0	0.0	0.0	0.0					
								SF	SF	EA	EA	EA	EA	EA	EA	EA		FT		EA	LB	LB	LB	LB					
VERMONT AGENCY OF TRANSPORTATION							TOWN DIRECTIONAL TOTALS	131.6	0.0	1	4	4	30	0	0	17		250.0		0		0.0							

PROJECT NAME: **STATEWIDE-SOUTHWEST**
PROJECT NUMBER: **STPG SIGN(51)**

FILE NAME: **z13e624tsswaitsfield EB** PLOT DATE: **4/28/2015**
PROJECT MANAGER: **C. BEAN** DRAWN BY: **S. GOODWIN**
DESIGNED BY: **S. GOODWIN** CHECKED **D. MUNRO**
WAITSFIELD VT-17 EASTBOUND 4 SHEET **96** OF **121**