DIRECTION	MILEPOINT	LOCATION CODE (SHEET 3)	SIGN CODE	WIDTH (IN)	HEIGHT (IN)	SHEETING REMARKS	SIGN LEGEND	NEW SIGNS "A"	NEW SIGNS "B"	EXISTING SIGNS RETAIN	EXISTING SIGNS SALVAGE FROM	EXISTING SIGNS SALVAGE TO	EXISTING SIGNS REMOVE	EXIST POST RETAIN	EXIST POST REMOVE	NUMBER OF NEW POSTS	SQUARE STEEL (IN) 1.75 (LB/FT) 1.88	SQUARE STEEL (IN) 2.00 (LB/FT) 2.42	SQUARE STEEL (IN) 2.50 (LB/FT) 3.35	TUBULAR STEEL Ø (IN) FOUNDATION	TUBULAR STEEL Ø (IN) 3.00 (LB/FT) 7.60	TUBULAR STEEL Ø (IN) 3.50 (LB/FT) 9.00	TUBULAR STEEL Ø (IN) 4.00 (LB/FT) 10.80	TUBULAR STEEL Ø (IN) 5.00 (LB/FT) 14.60	SIGN FRAME REQUIRED	REMARKS	SIGN DETAIL LOCATION SHSM	SIGN DETAIL LOCATION PROJECT SHEET #	SIGN DETAIL LOCATION STANDARD SHEET #
EB RUTLAND TOWN BUS 4							FY-FLUORESCENT YELLOW FYG-FLUORESCENT YELLOW GREEN																				"SHSM"-STANDARD HIGHWAY SIGNS AND MARKINGS BOOK			
		A	VD1-1A	72	12		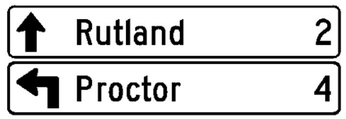 (CONT.)	6.00								2	13.75 14.25 X											10	
		A	VD1-1A	72	12			6.00																				10	
EB	0.548	A	W3-3	36	36								1	X			13.50 13.50												
		A	W3-3	36	36			9.00																				X	
EB	0.576	C	VR-017	24	30								1		X												SIMONS AVE (TH-43)		
		C	VR-017	24	30			5.00								1	13.00 X										INSTALL NEW SIGN AT SAME LOCATION ON SIMONS AVE			E-141
EB	0.589	AB	D3-1		12		Simons Ave				1		1		X														
		D	R1-1	30	30		STOP						1																
		C	VD-700	6	8		MILE MARKER 9990 / 1120 / 0059						1																
EB	0.589	AB	D3-1		12		Simons Ave					1				1	13.25 X										INSTALL 15 FT ± UP SIMONS AVE			
		D	R1-1	30	30			6.25																				X	
		C	VD-700	6	10			0.42																			INSTALL BACK TO BACK ON STOP SIGN POST			T-44
EB	0.591	A	M3-1	24	12			2.00								2	15.50 16.00 X									2A	NORTH, GREEN ON WHITE INSTALL ASSEMBLY AT EDGE OF TOWN HIGHWAY			E-136B
		A	VM1-5	24	24			4.00																						E-136B
		A	M6-1	21	15		(CONT. ON NEXT SHEET)	2.19																						E-136B
SIGN SUMMARY SHEET							SHEET TOTALS	40.86	0.00	0	1	1	5	0	0	6	~~90.0~~ 112.75			0	0.0	0.0	0.0	0.0					
								SF	SF	EA	EA	EA	EA	EA	EA	EA	FT			EA	LB	LB	LB	LB					
VERMONT AGENCY OF TRANSPORTATION							TOWN DIRECTIONAL TOTALS	230.1	0.0	11	2	2	54	0	0	28	405.0			0	0.0								

PROJECT NAME: **STATEWIDE-SOUTHWEST**
PROJECT NUMBER: **STPG SIGN(51)**
FILE NAME: **z13e624tssrutlandtown EB** PLOT DATE: **4/28/2015**
PROJECT MANAGER: **C. BEAN** DRAWN BY: **S. GOODWIN**
DESIGNED BY: **S. GOODWIN** CHECKED **D. MUNRO**
RUTLAND TOWN BUS-4 EASTBOUND 3 SHEET **106** OF **121**