DIRECTION	MILEPOINT	LOCATION CODE (SHEET 3)	SIGN CODE	WIDTH (IN)	HEIGHT (IN)	SHEETING REMARKS	SIGN LEGEND	NEW SIGNS "A"	NEW SIGNS "B"	EXISTING SIGNS RETAIN	EXISTING SIGNS SALVAGE FROM	EXISTING SIGNS SALVAGE TO	EXISTING SIGNS REMOVE	EXIST POST RETAIN	EXIST POST REMOVE	NUMBER OF NEW POSTS	SQUARE STEEL (IN) 1.75 (LB / FT) 1.88	SQUARE STEEL (IN) 2.00 (LB / FT) 2.42	SQUARE STEEL (IN) 2.50 (LB / FT) 3.35	TUBULAR STEEL Ø (IN) FOUNDATION	TUBULAR STEEL Ø (IN) 3.00 (LB / FT) 7.60	TUBULAR STEEL Ø (IN) 3.50 (LB / FT) 9.00	TUBULAR STEEL Ø (IN) 4.00 (LB / FT) 10.80	TUBULAR STEEL Ø (IN) 5.00 (LB / FT) 14.60	SIGN FRAME REQUIRED	REMARKS	SIGN DETAIL LOCATION SHSM	SIGN DETAIL LOCATION PROJECT SHEET #	SIGN DETAIL LOCATION STANDARD SHEET #
EB RUTLAND TOWN BUS 4							FY-FLUORESCENT YELLOW FYG-FLUORESCENT YELLOW GREEN																				"SHSM"-STANDARD HIGHWAY SIGNS AND MARKINGS BOOK			
EB	0.832	A	VR2-5A	24	30		REDUCED SPEED AHEAD						1	X															
		A	R8-3	24	24			4.00								1		12.50								INSTALL BEHIND SIDEWALK. PROVIDE 7' MIN. VERTICAL CLEARANCE.	X		
EB	0.856	C	VR-017	24	30		LEGAL LOAD LIMIT 24,000 LBS			1				X													DEPOT LN (TH-29)			
EB	0.863	AB	D-3	6	18		DEPOT LANE						1	X															
		D	R1-1	30	30		STOP				1		1																
		AB	D3-1	39	12			3.25								1		13.25								INSTALL PERPENDICULAR ON TOP OF STOP SIGN		12	
		D	R1-1	30	30		STOP	~~6.25~~				1																	
		C	VD-700	6	10		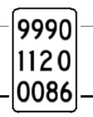	0.42																			INSTALL BACK TO BACK ON STOP SIGN POST			T-44
EB	0.872	A	R8-3	24	24		NO PARKING						1		X														
		A	M4-6	24	12		BEGIN						1																
EB	0.880	A	R8-3	24	24			4.00								1		12.50 X								INSTALL IN GREEN BELT. PROVIDE 7' MIN. VERTICAL CLEARANCE. INSTALL SIGN IN-LINE WITH BUSINESS SIGN.	X		
EB	0.890	A	R8-3	24	24		NO PARKING						1		X														
EB	0.929	A	R8-3	24	24								1	X																	
		A	R8-3	24	24			4.00								1		12.75								INSTALL IN GREEN BELT. PROVIDE 7' MIN. VERTICAL CLEARANCE.	X		
SIGN SUMMARY SHEET							SHEET TOTALS	~~21.92~~ 15.67 SF	0.00 SF	1 EA	1 EA	1 EA	7 EA	0 EA	0 EA	~~1~~ 4 EA		~~15.0~~ 51.00 FT		0 EA	0.0 LB	0.0 LB	0.0 LB	0.0 LB					
VERMONT AGENCY OF TRANSPORTATION							TOWN DIRECTIONAL TOTALS	230.1	0.0	11	2	2	54	0	0	28		405.0		0	0.0							

PROJECT NAME: **STATEWIDE-SOUTHWEST**
PROJECT NUMBER: **STPG SIGN(51)**
FILE NAME: **z13e624tssrutlandtown EB** PLOT DATE: **4/28/2015**
PROJECT MANAGER: **C. BEAN** DRAWN BY: **S. GOODWIN**
DESIGNED BY: **S. GOODWIN** CHECKED **D. MUNRO**
RUTLAND TOWN BUS-4 EASTBOUND 8 SHEET **111** OF **121**