DIRECTION	MILEPOINT	LOCATION CODE (SHEET 3)	SIGN CODE	WIDTH (IN)	HEIGHT (IN)	SHEETING REMARKS	SIGN LEGEND	NEW SIGNS "A"	NEW SIGNS "B"	EXISTING SIGNS RETAIN	EXISTING SIGNS SALVAGE FROM	EXISTING SIGNS SALVAGE TO	EXISTING SIGNS REMOVE	EXIST POST RETAIN	EXIST POST REMOVE	NUMBER OF NEW POSTS	SQUARE STEEL (IN) 1.75 (LB / FT) 1.88	SQUARE STEEL (IN) 2.00 (LB / FT) 2.42	SQUARE STEEL (IN) 2.50 (LB / FT) 3.35	TUBULAR STEEL Ø (IN) FOUNDATION	TUBULAR STEEL Ø (IN) 3.00 (LB / FT) 7.60	TUBULAR STEEL Ø (IN) 3.50 (LB / FT) 9.00	TUBULAR STEEL Ø (IN) 4.00 (LB / FT) 10.80	TUBULAR STEEL Ø (IN) 5.00 (LB / FT) 14.60	SIGN FRAME REQUIRED	REMARKS	SIGN DETAIL LOCATION SHSM	SIGN DETAIL LOCATION PROJECT SHEET #	SIGN DETAIL LOCATION STANDARD SHEET #
WB RUTLAND TOWN BUS 4							FY-FLUORESCENT YELLOW FYG-FLUORESCENT YELLOW GREEN																				"SHSM"-STANDARD HIGHWAY SIGNS AND MARKINGS BOOK			
WB	0.880	F	R8-3	24	24		NO PARKING						1		X												REMOVE SIGN. SEE PREVIOUS ENTRY. TOO CLOSE TO UTILITY POLE.			
WB	0.855	F	R8-3	24	24			4.00								1		12.50 X									INSTALL 50 FT ± EAST OF EXISTING SIGN AT MP 0.846.INSTALL IN GREEN BELT. PROVIDE MIN. 7 FT VERTICAL CLEARANCE.	X		
WB	0.846	F	R8-3	24	24		NO PARKING						1		X														
WB	0.818	F	M2-1	24	12		JCT						1		X														
		F	VM1-5	24	24		VT ROUTE 3						1																
		F	M2-1	21	15			2.19								1		13.75 X									JCT, GREEN ON WHITE INSTALL IN GREEN BELT. PROVIDE MIN. 7 FT VERTICAL CLEARANCE.			E-136B
		F	VM1-5	24	24			4.00																			VT ROUTE 3			E-136B
WB	0.796	F	R8-3	24	24		NO PARKING						1		X														
		F	M4-6	24	12		END						1																
		F	R3-9dP	30	12			2.50								1		13.75 X									INSTALL IN GREEN BELT. PROVIDE MIN. 7 FT VERTICAL CLEARANCE.	X		
		F	R8-3	24	24			4.00																				X		
WB	0.787	F	W3-3	36	36		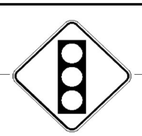						1	X													RETAIN POST / FLASHING BEACON			
		F	W3-3	36	36			9.00																			INSTALL NEW SIGN ON EXISTING POST	X		
WB	0.783	EF	D-3	12	4		<--- 24 TO 470				1		1		X												E PROCTOR RD (TH-59)			
		EF	D-3	30	6		EAST PROCTOR RD (CONT. ON NEXT SHEET)						1																	
SIGN SUMMARY SHEET							SHEET TOTALS	25.69	0.00	0	1	0	9	0	0	3		~~45.0~~ 40.00		0	0.0	0.0	0.0	0.0					
								SF	SF	EA	EA	EA	EA	EA	EA	EA		FT		EA	LB	LB	LB	LB					
VERMONT AGENCY OF TRANSPORTATION							TOWN DIRECTIONAL TOTALS	174.4	0.0	7	11	11	53	0	0	30		435.0		0	0.0								

PROJECT NAME: **STATEWIDE-SOUTHWEST**
PROJECT NUMBER: **STPG SIGN(51)**
FILE NAME: **z13e624tss rutlandtown WB** PLOT DATE: **4/28/2015**
PROJECT MANAGER: **C. BEAN** DRAWN BY: **S. GOODWIN**
DESIGNED BY: **S. GOODWIN** CHECKED **D. MUNRO**
RUTLAND TOWN BUS-4 WESTBOUND 2 SHEET **114** OF **121**