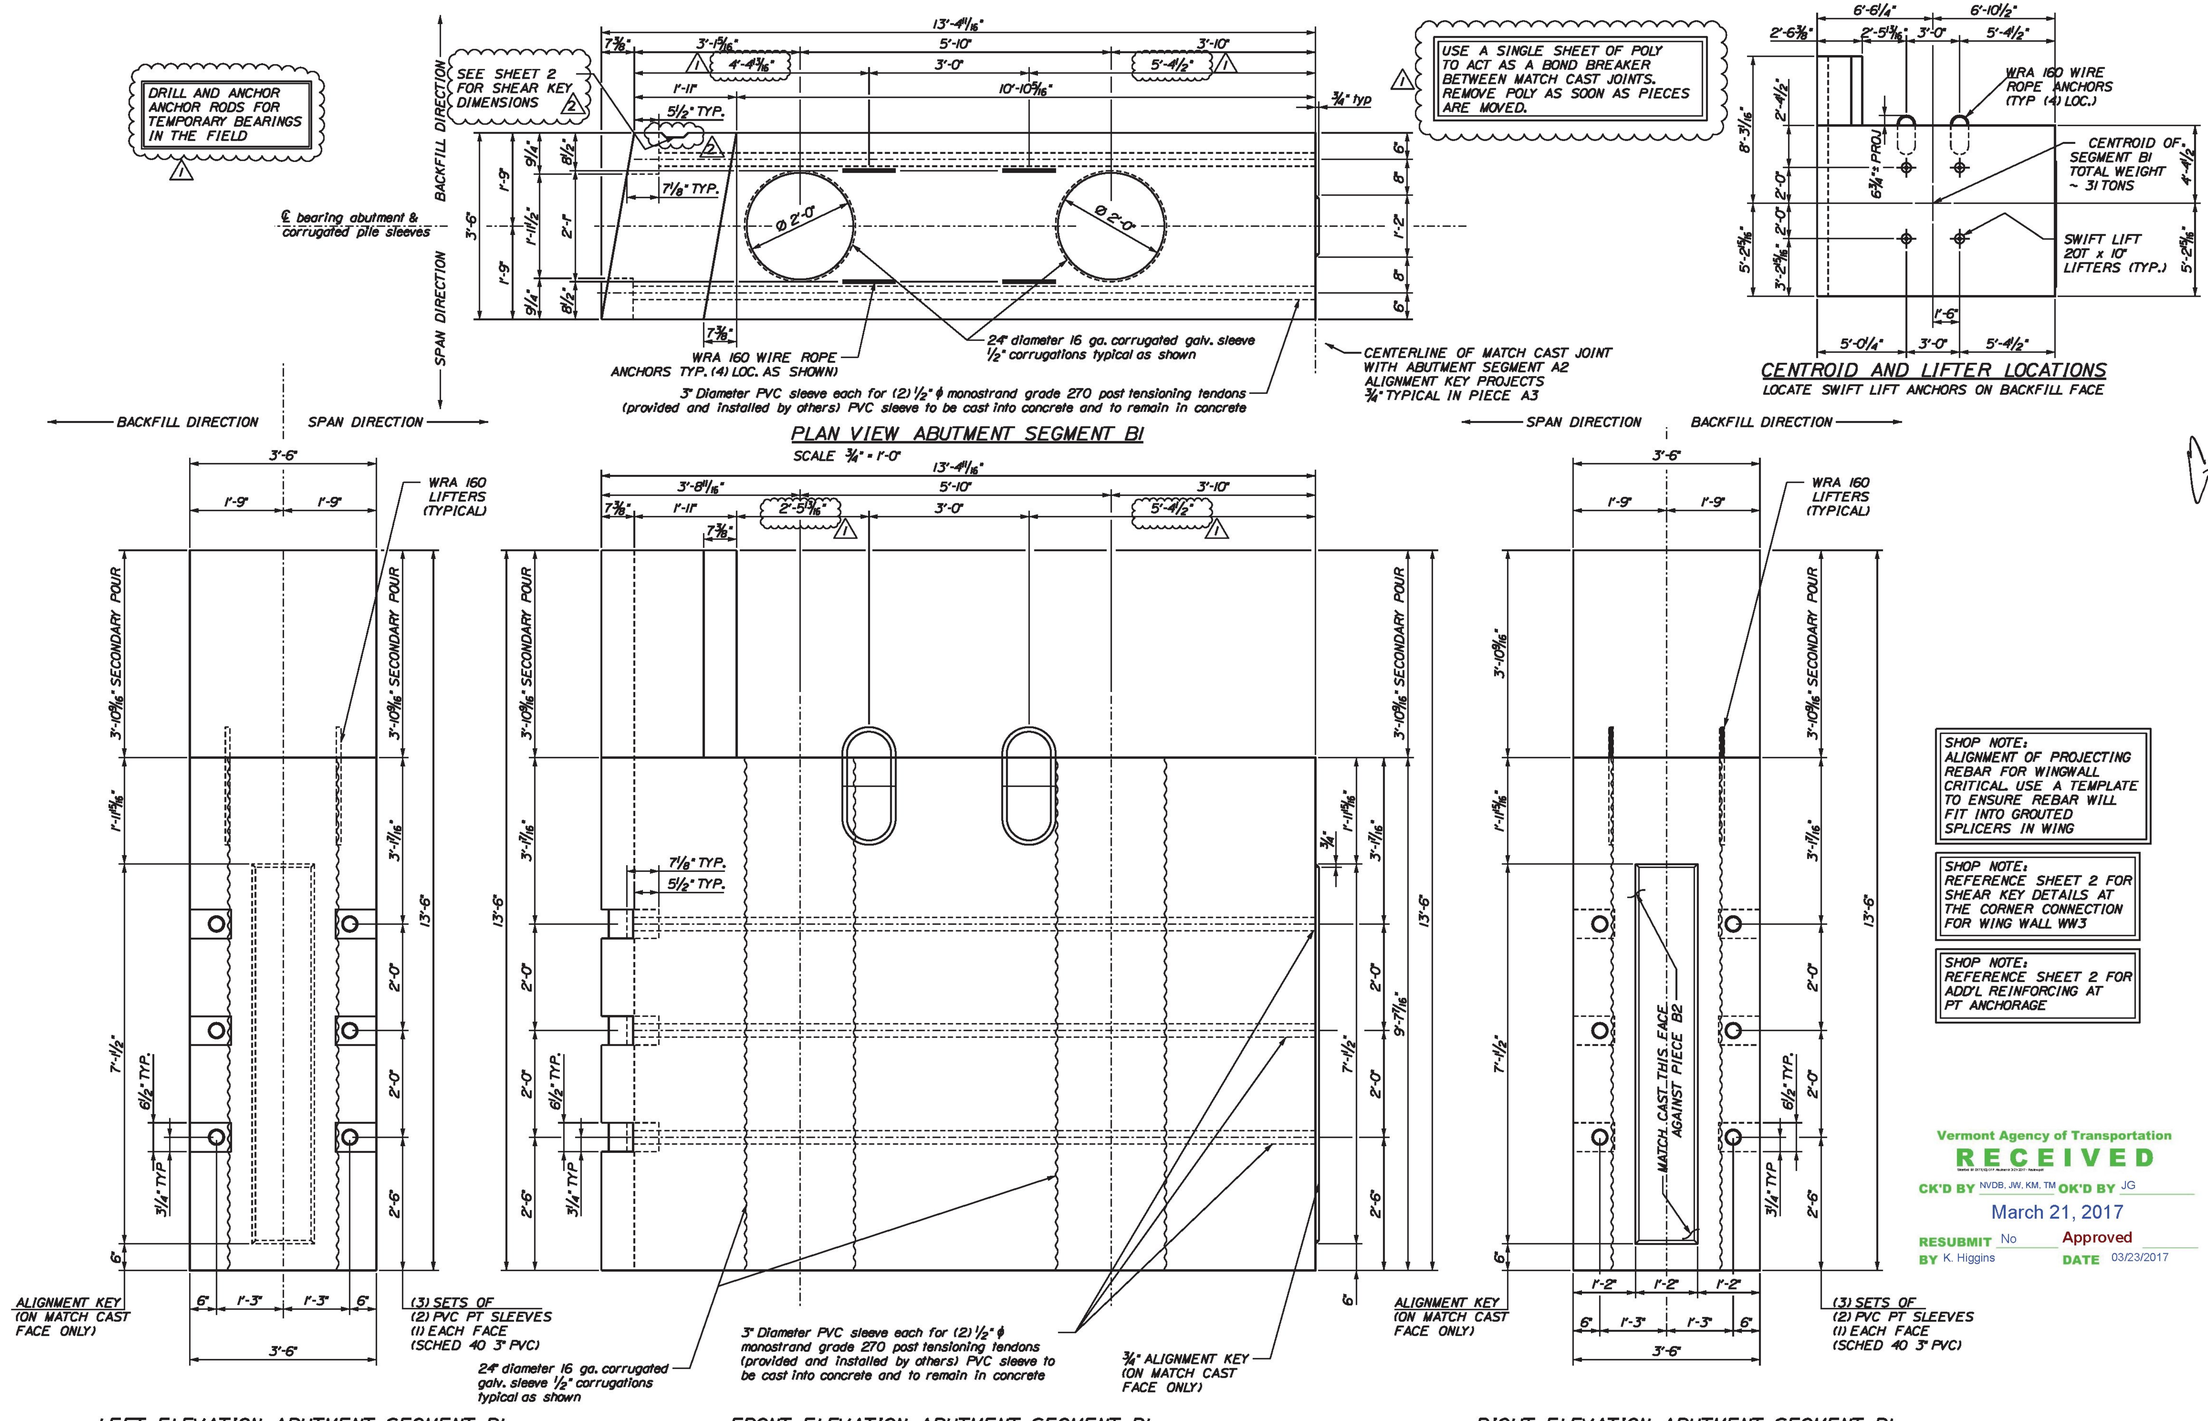


SHOP NOTE: ALIGNMENT OF PROJECTING REBAR FOR WINGWALL CRITICAL. USE A TEMPLATE TO ENSURE REBAR WILL FIT INTO GROUTED SPLICERS IN WING

SHOP NOTE: REFERENCE SHEET 2 FOR SHEAR KEY DETAILS AT THE CORNER CONNECTION FOR WING WALL WW3

SHOP NOTE: REFERENCE SHEET 2 FOR ADD'L REINFORCING AT PT ANCHORAGE

Vermont Agency of Transportation
RECEIVED
CK'D BY NVDB, JW, KM, TM OK'D BY JG
March 21, 2017
RESUBMIT No Approved
BY K. Higgins DATE 03/23/2017


CALDERWOOD ENGINEERING, ETC.
STRUCTURAL ENGINEERING • DETAILING SERVICES
222 RIVER RD, RICHMOND, ME 04357 PH/FX (207)737-2007 / 737-2008


PREPARED FOR:
MILLER CONSTRUCTION

STRAFFORD BF 0177(10)

STATE OF VERMONT ERIC T. CALDERWOOD NO. 8?? LICENSED PROFESSIONAL ENGINEER

P.E. NUMBER

DATE

| | BY | DATE |
|---|---|---|
| DESIGN-DETAILED | ETC | JAN 2017 |
| CHECKED-REVIEWED | | |
| REVISIONS 1 | ADDRESS VTRANS COMMENTS | FEB 2017 |
| REVISIONS 2 | ADDRESS VTRANS COMMENTS | MAR 2017 |
| REVISIONS 3 | | |
| REVISIONS 4 | | |
| FIELD CHANGES | | |

# STRAFFORD VERMONT ABUTMENT SHOP DETAILS

## SEGMENT B1 GEOMETRIC DETAILS

SHEET NUMBER

6

CALDERWOOD ENGINEERING, ETC. 222 RIVER ROAD RICHMOND, ME 04357 PH. (207) 737-2007 FAX (207) 737-2008