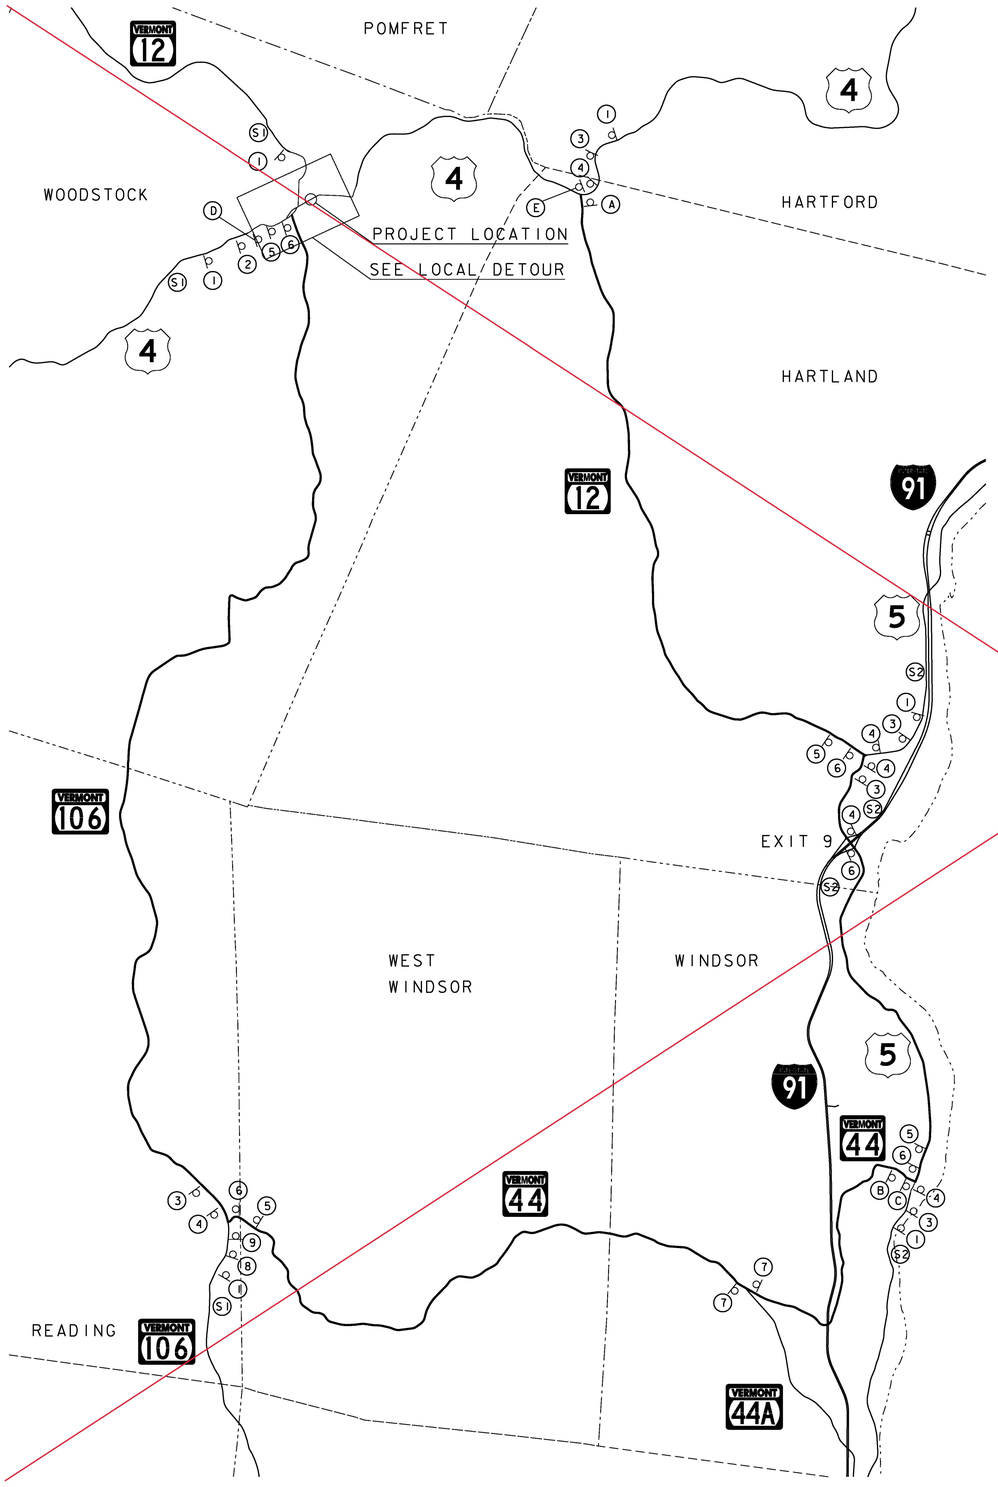

US 4 E	US 4 W	TRUCKS TO WHITE RIVER
VT 12 S	NO TRUCK	
NO TRUCK		

PORTABLE CHANGEABLE SIGN–S1–PHASE 1 | PORTABLE CHANGEABLE SIGN–S2–PHASE 1 | PORTABLE CHANGEABLE SIGN–S3–PHASE 1

TRUCKS TO RUTLAND		

PORTABLE CHANGEABLE SIGN–S4–PHASE 1

WOOD–	WOOD–	USE ROUTES 100&107
STOCK	STOCK	
VILLAGE	VILLAGE	

PORTABLE CHANGEABLE SIGN–S1–PHASE 2 | PORTABLE CHANGEABLE SIGN–S2–PHASE 2 | PORTABLE CHANGEABLE SIGN–S3–PHASE 2

USE I 89 EXIT 3

PORTABLE CHANGEABLE SIGN–S4–PHASE 2

* MMMM DD–	* MMMM DD–	* MMMM DD–
* MMMM DD	* MMMM DD	* MMMM DD

PORTABLE CHANGEABLE SIGN–S1–PHASE 3A | PORTABLE CHANGEABLE SIGN–S2–PHASE 3A | PORTABLE CHANGEABLE SIGN–S3–PHASE 3

* MMMM DD–
* MMMM DD

PORTABLE CHANGEABLE SIGN–S4–PHASE 3

TRUCKS DETOUR VT 106 S	TRUCKS DETOUR US 5 S

PORTABLE CHANGEABLE SIGN–S1–PHASE 3B | PORTABLE CHANGEABLE SIGN–S2–PHASE 3B

* M = MONTH
D = DAY

** US 4: EAST / WEST
VT 12: SOUTH / NORTH

PCMS S3 TO BE PLACED ON:
US ROUTE 4 EASTBOUND,
WEST OF THE INTERSECTION OF US ROUTE 4 & VT ROUTE 100.

PCMS S4 TO BE PLACED ON:
INTERSTATE 89 SOUTHBOUND,
APPROXIMATLY 1 MILE NORTH OF THE EXIT 3 OFFRAMP.
INTERSTATE 89 NORTHBOUND,
APPROXIMATLY 1 MILE SOUTH OF THE EXIT 1 OFFRAMP.
INTERSTATE 91 SOUTHBOUND,
BETWEEN THE EXIT 11 ON-RAMP AND THE 89-91 INTERCHANGE.
US ROUTE 4 WESTBOUND,
EAST OF THE INTERSTATE 89, EXIT 1 NORTHBOUND ON/OFF RAMP.

DURING ACTUAL CLOSURE SWITCH PCMS S1 AND S2 FROM PHASE 3A TO PHASE 3B, AND REMOVE PHASE 3 FROM PCMS S3 AND S4

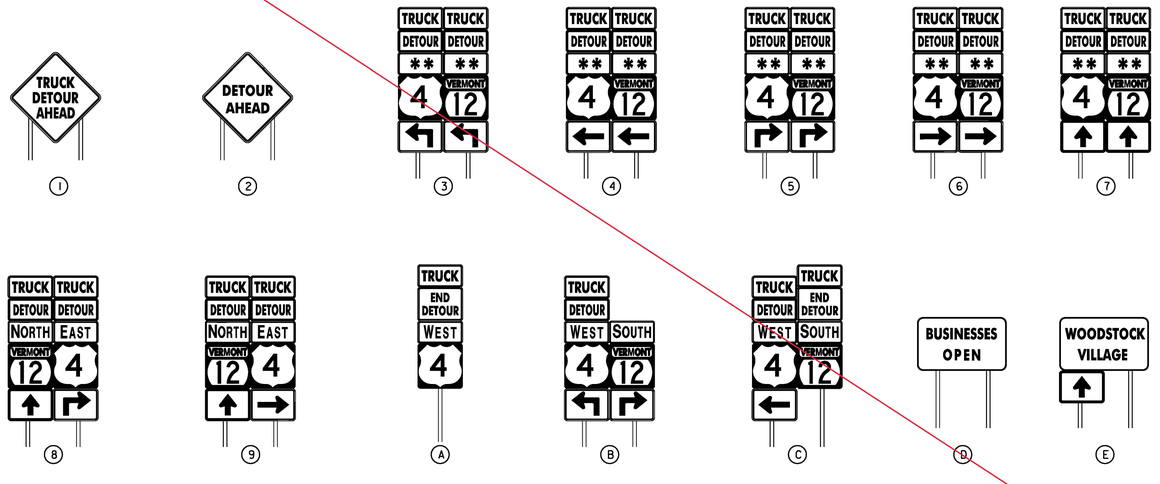

SHEET REVISED 1/11/18.
SEE NEW SHEET # 24A & 24B.

PROJECT NAME: WOODSTOCK VILLAGE
PROJECT NUMBER: BF 020-2(43)

FILE NAME: sl3j280detour.dgn
PROJECT LEADER: R. YOUNG
DESIGNED BY: W.LAMMER
REGIONAL TRUCK DETOUR

PLOT DATE: 21-AUG-2017
DRAWN BY: D.D.BEARD
CHECKED BY: W.LAMMER
SHEET 24 OF 53