DIRECTION	MILEPOINT	LOCATION CODE (SHEET 4)	SIGN CODE	WIDTH (IN)	HEIGHT (IN)	SHEETING REMARKS	SIGN LEGEND	NEW SIGNS "A"	NEW SIGNS "B"	EXISTING SIGNS RETAIN	EXISTING SIGNS SALVAGE FROM	EXISTING SIGNS SALVAGE TO	EXISTING SIGNS REMOVE	EXIST POST RETAIN	EXIST POST REMOVE	NUMBER OF NEW POSTS	SQUARE STEEL (IN) 1.75 (LB / FT) 1.88	SQUARE STEEL (IN) 2.00 (LB / FT) 2.42	SQUARE STEEL (IN) 2.50 (LB / FT) 3.35	TUBULAR STEEL Ø (IN) FOUNDATION	TUBULAR STEEL Ø (IN) 3.00 (LB / FT) 7.60	TUBULAR STEEL Ø (IN) 3.50 (LB / FT) 9.00	TUBULAR STEEL Ø (IN) 4.00 (LB / FT) 10.80	TUBULAR STEEL Ø (IN) 5.00 (LB / FT) 14.60	SIGN FRAME REQUIRED	REMARKS	SIGN DETAIL LOCATION SHSM	SIGN DETAIL LOCATION SIGN DETAIL SHEET #	SIGN DETAIL LOCATION STANDARD SHEET #
NB BARTON TH-3							FY-FLUORESCENT YELLOW FYG-FLUORESCENT YELLOW GREEN																				"SHSM"-STANDARD HIGHWAY SIGNS AND MARKINGS BOOK			
NB	1.834	AB	D3-1				(CONT.) CROSS RD			1				X												6-14-18			
NB	1.848	G	R1-1				STOP			1				X															
NB	1.907	A	W1-2L				LEFT CURVE						1		X														
		A	W13-1p				30 M.P.H. (PLAQUE)						1																
		A	W1-1L	30	30			6.25								1		15.25 X									X		
		A	W13-1p	18	18			2.25																			X		
NB	1.929	A	W1-8	24	30		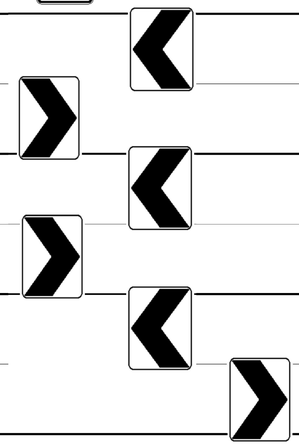	5.00								1		14.75 X 14.75								INSTALL 115 FT ± NORTH OF REPLACED SIGNS AT MP 1.907	X		
NB	1.930	B	W1-8	24	30			5.00																			X		
NB	1.952	A	W1-8	24	30			5.00								1		14.00 X 14.25								INSTALL 121 FT ± NORTH OF PROPOSED SIGNS AT MP 1.929	X		
NB	1.953	B	W1-8	24	30			5.00																			X		
NB	1.974	A	W1-8	24	30			5.00								1		12.75 X 12.75								INSTALL 115 FT ± NORTH OF PROPOSED SIGNS AT MP 1.952	X		
NB	1.975	B	W1-8	24	30			5.00																			X		
NB	2.165	A	W11-2				PEDESTRIAN SYMBOL						1		X														
NB	2.745	A	R2-1	24	30			5.00								1		15.25 X								INSTALL ACROSS FROM PROPOSED SL SIGN AT MP 2.745 ON SB SIDE	X		
							SHEET TOTALS	43.50	0.00	2	0	0	3	0	0	5		113.75 ~~75.0~~		0	0.0	0.0	0.0	0.0				
								SF	SF	EA	EA	EA	EA	EA	EA	EA		FT		EA	LB	LB	LB	LB				
							TOWN DIRECTIONAL TOTALS	77.5	0.0	4	3	3	13	0	0	13		195.0		0	0.0							

SIGN SUMMARY SHEET

VERMONT AGENCY OF TRANSPORTATION

PROJECT NAME: **STATEWIDE-NORTH REGION**
PROJECT NUMBER: **STP HRRR(22)**

FILE NAME: **z14k100tssbarton TH3 NB.xls** PLOT DATE: **5/5/2017**
PROJECT MANAGER: **K. RUTTER** DRAWN BY: **R. SHEDD**
DESIGNED BY: **R. SHEDD** CHECKED **S. GOODWIN**
BARTON TH-3 NORTHBOUND 2 SHEET **44** OF **255**