DIRECTION	MILEPOINT	LOCATION CODE (SHEET 4)	SIGN CODE	WIDTH (IN)	HEIGHT (IN)	SHEETING REMARKS	SIGN LEGEND	NEW SIGNS "A"	NEW SIGNS "B"	EXISTING SIGNS RETAIN	EXISTING SIGNS SALVAGE FROM	EXISTING SIGNS SALVAGE TO	EXISTING SIGNS REMOVE	EXIST POST RETAIN	EXIST POST REMOVE	NUMBER OF NEW POSTS	SQUARE STEEL (IN) 1.75 (LB / FT) 1.88	SQUARE STEEL (IN) 2.00 (LB / FT) 2.42	SQUARE STEEL (IN) 2.50 (LB / FT) 3.35	TUBULAR STEEL Ø (IN) FOUNDATION	TUBULAR STEEL Ø (IN) 3.00 (LB / FT) 7.60	TUBULAR STEEL Ø (IN) 3.50 (LB / FT) 9.00	TUBULAR STEEL Ø (IN) 4.00 (LB / FT) 10.80	TUBULAR STEEL Ø (IN) 5.00 (LB / FT) 14.60	SIGN FRAME REQUIRED	REMARKS	SIGN DETAIL LOCATION SHSM	SIGN DETAIL LOCATION SIGN DETAIL SHEET #	SIGN DETAIL LOCATION STANDARD SHEET #
NB CABOT TH-1							FY-FLUORESCENT YELLOW FYG-FLUORESCENT YELLOW GREEN																			"SHSM"-STANDARD HIGHWAY SIGNS AND MARKINGS BOOK			
NB	1.652	A	S3-1				SCHOOL BUS STOP AHEAD						1		X											6-13-18			
		A	S3-1	36	36	FYG		9.00								2		13.00 X ~~13.00~~								X		
NB	1.662	A	W14-1				DEAD END						1		X													
		A	W14-1	30	30			6.25								1		14.00 X								X		
NB	1.667	D	R1-1				STOP						1		X													
		D	R1-1	30	30			6.25								1		15.00 X								X		
NB	1.667	AB	D3-1	52	12			4.33								2		12.75 X ~~12.75~~								SIGN 6-19-18 REMOVALS 6-13-18		2	
NB	1.863	C	W1-7	48	24		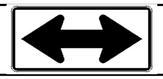	8.00					3			2		12.75 X ~~12.75~~								INSTALL ACROSS FROM WEST HILL POND RD 6-13-18	X		
NB	2.250	A	W1-1R				RIGHT TURN				1		1		X													
		A	W13-1p				30 MPH (PLAQUE)				1		1													SALVAGE SIGNS TO NEW LOCATION AT MP 2.285.			
NB	2.285	A	W1-1R	30	30			SALV. ~~6.25~~				1				1		15.25 X								TWO (2) ORANGE FLAGS TO BE MOUNTED ABOVE THE SIGN AT THE MIDPOINT OF EACH SIDE. FLAGS WILL BE CONSIDERED INCIDENTAL TO ITEM 675.20 - TRAFFIC SIGNS TYPE A.	X		
		A	W13-1p	18	18			SALV. ~~2.25~~				1															X		
NB	2.331	A	W5-2				NARROW BRIDGE			1				X															
NB	2.376	A	OM3-R				OBJECT MARKER			1				X															
NB	2.382	B	OM3-L				OBJECT MARKER			1				X															
SIGN SUMMARY SHEET							SHEET TOTALS	~~33.83~~ ~~42.33~~ SF	0.00 SF	3 EA	2 EA	2 EA	~~8~~ ~~5~~ EA	0 EA	0 EA	9 EA		121.25 ~~135.0~~ FT		0 EA	0.0 LB	0.0 LB	0.0 LB	0.0 LB					
VERMONT AGENCY OF TRANSPORTATION							TOWN DIRECTIONAL TOTALS	301.9	0.0	18	8	8	47	1	0	58		870.0		0	0.0								

PROJECT NAME: **STATEWIDE-NORTH REGION**
PROJECT NUMBER: **STP HRRR(22)**

FILE NAME: **z14k100tsscabot TH1 NB**
PROJECT MANAGER: **K. RUTTER**
DESIGNED BY: **R. SHEDD**
CABOT TH-1 NORTHBOUND 2

PLOT DATE: **5/5/2017**
DRAWN BY: **R. SHEDD**
CHECKED **S. GOODWIN**
SHEET **59** OF **255**