DIRECTION	MILEPOINT	LOCATION CODE (SHEET 4)	SIGN CODE	WIDTH (IN)	HEIGHT (IN)	SHEETING REMARKS	SIGN LEGEND	NEW SIGNS "A"	NEW SIGNS "B"	EXISTING SIGNS RETAIN	EXISTING SIGNS SALVAGE FROM	EXISTING SIGNS SALVAGE TO	EXISTING SIGNS REMOVE	EXIST POST RETAIN	EXIST POST REMOVE	NUMBER OF NEW POSTS	SQUARE STEEL (IN) 1.75 (LB / FT) 1.88	SQUARE STEEL (IN) 2.00 (LB / FT) 2.42	SQUARE STEEL (IN) 2.50 (LB / FT) 3.35	TUBULAR STEEL Ø (IN) FOUNDATION	TUBULAR STEEL Ø (IN) 3.00 (LB / FT) 7.60	TUBULAR STEEL Ø (IN) 3.50 (LB / FT) 9.00	TUBULAR STEEL Ø (IN) 4.00 (LB / FT) 10.80	TUBULAR STEEL Ø (IN) 5.00 (LB / FT) 14.60	SIGN FRAME REQUIRED	REMARKS	SIGN DETAIL LOCATION SHSM	SIGN DETAIL LOCATION SIGN DETAIL SHEET #	SIGN DETAIL LOCATION STANDARD SHEET #
NB CABOT TH-1							FY-FLUORESCENT YELLOW FYG-FLUORESCENT YELLOW GREEN																				"SHSM"-STANDARD HIGHWAY SIGNS AND MARKINGS BOOK			
NB	4.500	D	R1-1				STOP						1		X												6-5-18			
		D	R1-1	30	30			6.25								1		12.75 X										X		
NB	4.522	D	R1-1				STOP						1		X															
		CD	D3-1				RTE 215 N						1																	
		AB	D3-1				CABOT PLAINS RD				1		1													SALVAGE TO TWO NEW POSTS AT SAME LOCATION			
		D	R1-1	30	30			6.25								1		12.50 X										X		
NB	4.522	CD	D3-1	36	12			3.00								2		10.25 X 10.50											2	
		AB	D3-1				CABOT PLAINS RD				1																			
NB	5.960	C	W1-7	48	24		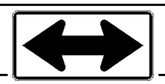	8.00								2		13.00 X 13.00									6-1-18	X		
NB	5.998	AB	D3-1				TETRAULT RD						1		X															
		AB	D3-1	52	12			4.33								2		12.00 X 12.00									MOUNT TETREAULT RD AT LEAST 10 FT. FROM STOP SIGN		3	
		D	R1-1	30	30			6.25								1		X 12.75										X		
SIGN SUMMARY SHEET							SHEET TOTALS	34.08	0.00	0	1	1	5	0	0	8		108.75 ~~120.0~~		0	0.0	0.0	0.0	0.0						
								SF	SF	EA	EA	EA	EA	EA	EA	EA		FT		EA	LB	LB	LB	LB						
VERMONT AGENCY OF TRANSPORTATION							TOWN DIRECTIONAL TOTALS	301.9	0.0	18	8	8	47	1	0	58		870.0		0	0.0									

PROJECT NAME: **STATEWIDE-NORTH REGION**
PROJECT NUMBER: **STP HRRR(22)**

FILE NAME: **z14k100tsscabot TH1 NB**
PROJECT MANAGER: **K. RUTTER**
DESIGNED BY: **R. SHEDD**
CABOT TH-1 NORTHBOUND 8

PLOT DATE: **5/5/2017**
DRAWN BY: **R. SHEDD**
CHECKED **S. GOODWIN**
SHEET **65** OF **255**