DIRECTION	MILEPOINT	LOCATION CODE (SHEET 4)	SIGN CODE	WIDTH (IN)	HEIGHT (IN)	SHEETING REMARKS	SIGN LEGEND	NEW SIGNS "A"	NEW SIGNS "B"	EXISTING SIGNS RETAIN	EXISTING SIGNS SALVAGE FROM	EXISTING SIGNS SALVAGE TO	EXISTING SIGNS REMOVE	EXIST POST RETAIN	EXIST POST REMOVE	NUMBER OF NEW POSTS	SQUARE STEEL (IN) 1.75 (LB / FT) 1.88	SQUARE STEEL (IN) 2.00 (LB / FT) 2.42	SQUARE STEEL (IN) 2.50 (LB / FT) 3.35	TUBULAR STEEL Ø (IN) FOUNDATION	TUBULAR STEEL Ø (IN) 3.00 (LB / FT) 7.60	TUBULAR STEEL Ø (IN) 3.50 (LB / FT) 9.00	TUBULAR STEEL Ø (IN) 4.00 (LB / FT) 10.80	TUBULAR STEEL Ø (IN) 5.00 (LB / FT) 14.60	SIGN FRAME REQUIRED	REMARKS	SIGN DETAIL LOCATION SHSM	SIGN DETAIL LOCATION SIGN DETAIL SHEET #	SIGN DETAIL LOCATION STANDARD SHEET #
NB DANVILE TH-3							FY-FLUORESCENT YELLOW FYG-FLUORESCENT YELLOW GREEN																			"SHSM"-STANDARD HIGHWAY SIGNS AND MARKINGS BOOK			
NB	0.194	D	R1-1				MM ARROW ~~STOP~~				1	1	1 1		X											5-17-18			
		AB	D3-1				OLD COUNTY RD / TH-53						1																
		D	R1-1	30	30			6.25								1		13.50 X								X		
NB	0.194	AB	D3-1	60	12			5.00								2		11.50 X ~~12.25~~								INSTALL NEXT TO STOP SIGN		4	
NB	0.210	A	W1-8				LEFT CHEVRON			1				X															
		B	W1-8				RIGHT CHEVRON			1																			
NB	0.439	A	VW-133L										1		X														
		A	VW-133L	30	30			6.25								1		15.00 X										T-81
NB	0.876	A	W3-5	36	36			9.00								2		14.25 X ~~15.00~~								INSTALL 230 FT ± SOUTH OF UTILITY POLE 59 AT MP 0.920	X		
NB	0.919	A	R2-1				SPEED LIMIT 35						1		X														
NB	0.942	A	R2-1	30	36		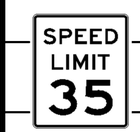	7.50								1		14.75 X									X		
NB	1.030 - 1.074	A		6	8		INSTALL (5) NEW DELINEATOR POSTS																			INSTALL (10) TYPE II 6"x8" WHITE DELINEATORS BACK TO BACK ON 5 NEW POSTS; INSTALL FIRST POST AT MP 1.030 580 FT ± NORTH OF EXIS. TELEPHONE POLE, THEN EVERY 60 FT ±, SEE SHEET 9			
NB	1.046	A	W3-5				NARROW BRIDGE						1		X												5-18-18			
NB	1.145	A	W3-5	36	36			9.00								2		14.25 X ~~15.00~~							5 DEL	INSTALL 115 FT ± SOUTH OF UTILITY POLE 54/48/64 AT MP 1.167	X		
							SHEET TOTALS	43.00	0.00	2	~~1~~ 0	~~1~~ 0	~~6~~ 5	0	0	9		~~125.50~~ 135.0		0	0.0	0.0	0.0	0.0				
								SF	SF	EA	EA	EA	EA	EA	EA	EA		FT		EA	LB	LB	LB	LB				
							TOWN DIRECTIONAL TOTALS	163.3	0.0	14	0	0	10	0	0	30		450.0		0	0.0							

SIGN SUMMARY SHEET

VERMONT AGENCY OF TRANSPORTATION

PROJECT NAME: **STATEWIDE-NORTH REGION**
PROJECT NUMBER: **STP HRRR(22)**

FILE NAME: **z14k100tssdanville TH3 NB.xl**s PLOT DATE: **5/5/2017**
PROJECT MANAGER: **K. RUTTER** DRAWN BY: **R. SHEDD**
DESIGNED BY: **R. SHEDD** CHECKED **S. GOODWIN**
DANVILLE TH-3 NORTHBOUND 2 SHEET **76** OF **255**