DIRECTION	MILEPOINT	LOCATION CODE (SHEET 4)	SIGN CODE	WIDTH (IN)	HEIGHT (IN)	SHEETING REMARKS	SIGN LEGEND	NEW SIGNS "A"	NEW SIGNS "B"	EXISTING SIGNS RETAIN	EXISTING SIGNS SALVAGE FROM	EXISTING SIGNS SALVAGE TO	EXISTING SIGNS REMOVE	EXIST POST RETAIN	EXIST POST REMOVE	NUMBER OF NEW POSTS	SQUARE STEEL (IN) 1.75 (LB / FT) 1.88	SQUARE STEEL (IN) 2.00 (LB / FT) 2.42	SQUARE STEEL (IN) 2.50 (LB / FT) 3.35	TUBULAR STEEL Ø (IN) FOUNDATION	TUBULAR STEEL Ø (IN) 3.00 (LB / FT) 7.60	TUBULAR STEEL Ø (IN) 3.50 (LB / FT) 9.00	TUBULAR STEEL Ø (IN) 4.00 (LB / FT) 10.80	TUBULAR STEEL Ø (IN) 5.00 (LB / FT) 14.60	SIGN FRAME REQUIRED	REMARKS	SIGN DETAIL LOCATION SHSM	SIGN DETAIL LOCATION SIGN DETAIL SHEET #	SIGN DETAIL LOCATION STANDARD SHEET #
SB DANVILLE TH-3							FY-FLUORESCENT YELLOW FYG-FLUORESCENT YELLOW GREEN																			"SHSM"-STANDARD HIGHWAY SIGNS AND MARKINGS BOOK			
SB	1.564	F	W7-1				HILL WARNING						1		X											5-19-18			
		F	W7-1	30	30			6.25								1		14.00 X									X		
SB	1.498	EF	D3-1				ONEIDA RD						1																
		H	R1-1				STOP						1		X														
		EF	D3-1	42	12			3.50																	MOUNT ONEIDA RD PERP ON TOP OF STOP SIGN		4	
		H	R1-1	30	30			6.25								1		13.75 X									X		
SB	1.389	F					NARROW BRIDGE						1		X														
SB	1.307	F	W3-5	36	36			9.00								2		15.50 X ~~16.50~~									INSTALL 395 FT ± SOUTH OF EXISTING SIGN AT MP 1.382	X		
SB	1.269	F	W1-1MgL	36	36		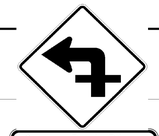	9.00								2		15.00 X 15.50									INSTALL 140 FT ± NORTH OF RETAINED SIGN AT MP 1.242		26	
		F	W16-8a	48	15			5.00																				5	
		F	W13-1p	18	18			2.25																				X	
SB	1.242	EF	D3-1				HARVEYS HOLLOW RD			1				X													5-21-18			
		H	R1-1				STOP			1																				
SB	1.237	F	OM3-R				OBJECT MARKER						1		X															
		F	OM3-R	12	36			3.00								1		10.75 X										X		
SIGN SUMMARY SHEET							SHEET TOTALS	44.25	0.00	2	0	0	5	0	0	7		~~101.0~~ ~~105.0~~		0	0.0	0.0	0.0	0.0					
								SF	SF	EA	EA	EA	EA	EA	EA	EA		FT		EA	LB	LB	LB	LB					
VERMONT AGENCY OF TRANSPORTATION							TOWN DIRECTIONAL TOTALS	215.6	0.0	6	0	0	19	0	0	34		510.0		0	0.0								

PROJECT NAME: **STATEWIDE-NORTH REGION**
PROJECT NUMBER: **STP HRRR(22)**
FILE NAME: **z14k100tssdanvilleTH3 SB.xls** PLOT DATE: **5/5/2017**
PROJECT MANAGER: **K. RUTTER** DRAWN BY: **R. SHEDD**
DESIGNED BY: **R. SHEDD** CHECKED **S. GOODWIN**
DANVILLE TH-3 SOUTHBOUND 3 SHEET **81** OF **255**