DIRECTION	MILEPOINT	LOCATION CODE (SHEET 4)	SIGN CODE	WIDTH (IN)	HEIGHT (IN)	SHEETING REMARKS	SIGN LEGEND	NEW SIGNS "A"	NEW SIGNS "B"	EXISTING SIGNS RETAIN	EXISTING SIGNS SALVAGE FROM	EXISTING SIGNS SALVAGE TO	EXISTING SIGNS REMOVE	EXIST POST RETAIN	EXIST POST REMOVE	NUMBER OF NEW POSTS	SQUARE STEEL (IN) 1.75 (LB / FT) 1.88	SQUARE STEEL (IN) 2.00 (LB / FT) 2.42	SQUARE STEEL (IN) 2.50 (LB / FT) 3.35	FOUNDATION	TUBULAR STEEL Ø (IN) 3.00 (LB / FT) 7.60	TUBULAR STEEL Ø (IN) 3.50 (LB / FT) 9.00	TUBULAR STEEL Ø (IN) 4.00 (LB / FT) 10.80	TUBULAR STEEL Ø (IN) 5.00 (LB / FT) 14.60	SIGN FRAME REQUIRED	REMARKS	SIGN DETAIL LOCATION SHSM	SIGN DETAIL LOCATION SIGN DETAIL SHEET #	SIGN DETAIL LOCATION STANDARD SHEET #
SB DANVILLE TH-3							FY-FLUORESCENT YELLOW FYG-FLUORESCENT YELLOW GREEN																			"SHSM"-STANDARD HIGHWAY SIGNS AND MARKINGS BOOK			
SB	1.226	E	OM3-L				OBJECT MARKER						1		X											5-21-18			
		E	OM3-L	12	36			3.00								1		10.50 X									X		
SB	1.209	F	W1-2L				LEFT CURVE						1		X														
		F	W1-6	48	24			8.00								2		12.25 X ~~12.25~~									X		
SB	0.942	F					END SPEED 35						1		X											5-18-18			
		F	R2-1	24	30			5.00								1		14.50 X									X		
SB	0.522	EF	D3-1				CURRIER RD						1		X														
			D3-1	42	12			3.50								1		11.75 X										4	
SB	0.255	F	W1-10R	36	36			9.00								2		15.25 X 15.75								INSTALL 120 FT ± NORTH OF UTILITY POLE 320/80 AT MP 0.223	X		
		F	W16-8p	36	8			2.00																				5	
		F	W13-1p	18	18			2.25																		INSTALL ON LEFT POST	X		
SB	0.194						REMOVE EMPTY POST								X											~~PAID FOR AS ITEM 676.12, REMOVAL OF EXISTING DELINEATOR, SEE SHEET 7~~	MISSING		
		G	W1-7	48	24		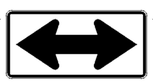	8.00								2		12.00 X ~~12.00~~									X		
SB	0.124	EF	D3-1				EVERGREEN LN						2 ~~1~~		X											BACK-TO-BACK			
		EF	D3-1	56	12			4.67								1		10.25 X ~~10.25~~										4	
SIGN SUMMARY SHEET							SHEET TOTALS	45.42	0.00	0	0	0	6 ~~5~~	0	0	10		136.75 150.0		0	0.0	0.0	0.0	0.0					
								SF	SF	EA	EA	EA	EA	EA	EA	EA		FT		EA	LB	LB	LB	LB					
VERMONT AGENCY OF TRANSPORTATION							TOWN DIRECTIONAL TOTALS	215.6	0.0	6	0	0	19	0	0	34		510.0		0	0.0								

PROJECT NAME: **STATEWIDE-NORTH REGION**
PROJECT NUMBER: **STP HRRR(22)**

FILE NAME: **z14k100tssdanvilleTH3 SB.xls** PLOT DATE: **5/5/2017**
PROJECT MANAGER: **K. RUTTER** DRAWN BY: **R. SHEDD**
DESIGNED BY: **R. SHEDD** CHECKED **S. GOODWIN**
DANVILLE TH-3 SOUTHBOUND 4 SHEET **82** OF **255**