DIRECTION	MILEPOINT	LOCATION CODE (SHEET 4)	SIGN CODE	WIDTH (IN)	HEIGHT (IN)	SHEETING REMARKS	SIGN LEGEND	NEW SIGNS "A"	NEW SIGNS "B"	EXISTING SIGNS RETAIN	EXISTING SIGNS SALVAGE FROM	EXISTING SIGNS SALVAGE TO	EXISTING SIGNS REMOVE	EXIST POST RETAIN	EXIST POST REMOVE	NUMBER OF NEW POSTS	SQUARE STEEL (IN) 1.75 (LB / FT) 1.88	SQUARE STEEL (IN) 2.00 (LB / FT) 2.42	SQUARE STEEL (IN) 2.50 (LB / FT) 3.35	TUBULAR STEEL Ø (IN) FOUNDATION	TUBULAR STEEL Ø (IN) 3.00 (LB / FT) 7.60	TUBULAR STEEL Ø (IN) 3.50 (LB / FT) 9.00	TUBULAR STEEL Ø (IN) 4.00 (LB / FT) 10.80	TUBULAR STEEL Ø (IN) 5.00 (LB / FT) 14.60	SIGN FRAME REQUIRED	REMARKS	SIGN DETAIL LOCATION SHSM	SIGN DETAIL LOCATION SIGN DETAIL SHEET #	SIGN DETAIL LOCATION STANDARD SHEET #
NB FAIRFIELD TH-1							FY-FLUORESCENT YELLOW FYG-FLUORESCENT YELLOW GREEN																			"SHSM"-STANDARD HIGHWAY SIGNS AND MARKINGS BOOK			
NB	0.055	A					HIDDEN SIDE ROAD RIGHT						1		X											6-15-18			
NB	0.072						DETECTION AREA AT MM 0.072 ON THE SIDE ROAD SIGN ASSEMBLY																			INSTALL 80 FT ± NORTH OF UTILITY POLE 238 AT MP 0.057, PAID FOR AS ITEM 900.645 SPECIAL PROVISION (LED ENHANCED INTERSECTION WARNING SYSTEM) SEE SHEET 12 FOR ADDITIONAL INFORMATION			
NB	0.072	A					BEACON									~~2~~		~~X~~								ALUM. PEDESTALS			
NB	0.072	A	W2-2R	36	36		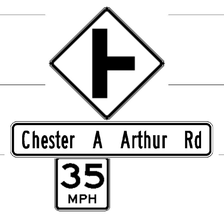																			INSTALL 80 FT ± NORTH OF UTILITY POLE 238 AT MP 0.057. SEE SHT 12 FOR ADDITIONAL INFORMATION. W2-2R PAID FOR IN SPECIAL PROVISION.	X		
		A	W16-8p	48	8			2.67																				6	
		A	W13-1p	18	18			2.25																			X		
NB	0.129	A					PRES. ARTHUR HISTORIC SITE			1					X															
NB	0.179						DETECTION AREA AT MM .179 ON THE YIELD SIGN ASSEMBLY ON CHESTER A ARTHUR RD																			INSTALL ON CHESTER A ARTHUR RD, PAID FOR AS ITEM NO. 900.645 SPECIAL PROVISION (LED ENHANCED INTERSECTION WARNING SYSTEM) SEE SHEET 12 FOR ADDITIONAL INFORMATION			
SIGN SUMMARY SHEET							SHEET TOTALS	4.92	0.00	1	0	0	1	0	0	2		~~0.00~~ ~~30.0~~		0	0.0	0.0	0.0	0.0					
								SF	SF	EA	EA	EA	EA	EA	EA	EA		FT		EA	LB	LB	LB	LB					
VERMONT AGENCY OF TRANSPORTATION							TOWN DIRECTIONAL TOTALS	4.9	0.0	1	0	0	1	0	0	2		30.0		0	0.0								

PROJECT NAME: **STATEWIDE-NORTH REGION**
PROJECT NUMBER: **STP HRRR(22)**

FILE NAME: **z14k100tssfairfield TH1 NB.xl**
PROJECT MANAGER: **K. RUTTER**
DESIGNED BY: **R. SHEDD**
FAIRFIELD TH-1 NORTHBOUND 1

PLOT DATE: **5/5/2017**
DRAWN BY: **R. SHEDD**
CHECKED **S. GOODWIN**
SHEET **84** OF **255**